


T. 19 S., R. 1 W., W.M.

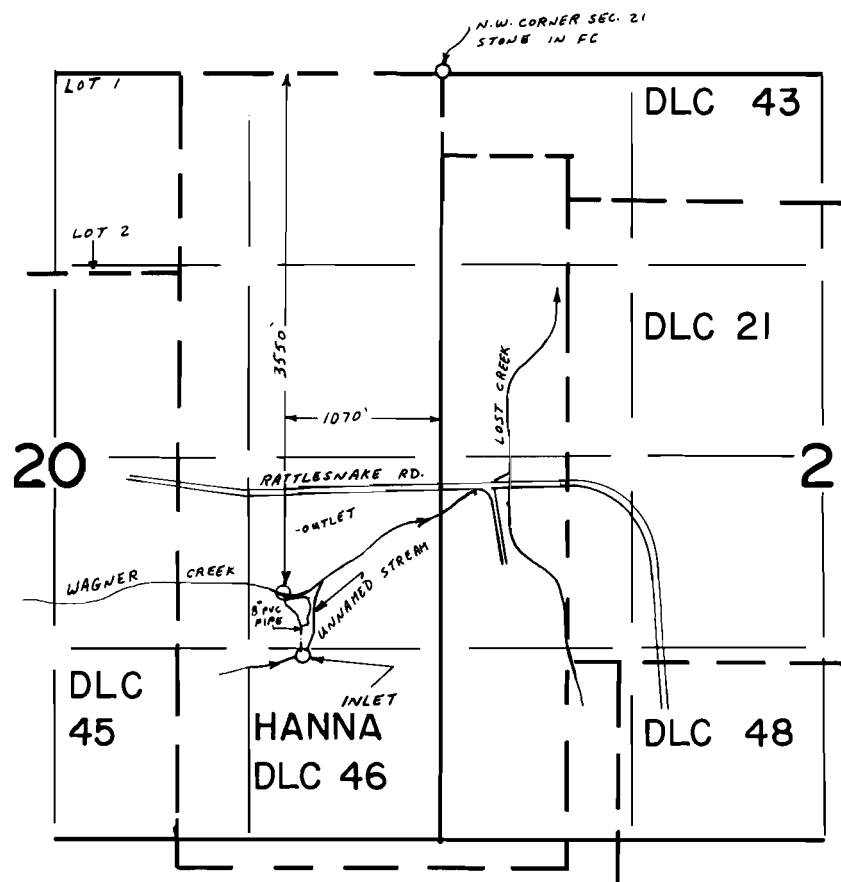

SCALE 1" = 1320'

# FINAL PROOF SURVEY

UNDER

Application No. **R-57248** Permit No. **R-7511**

IN NAME OF

**WILLIAM A. & VALERE A. MILLER**

Surveyed **MAY 24 88** by **Z. SALEH**

DBQ-4JJ-96  
5-3-89 Z.f.S.