


T19S. RIW. WM.

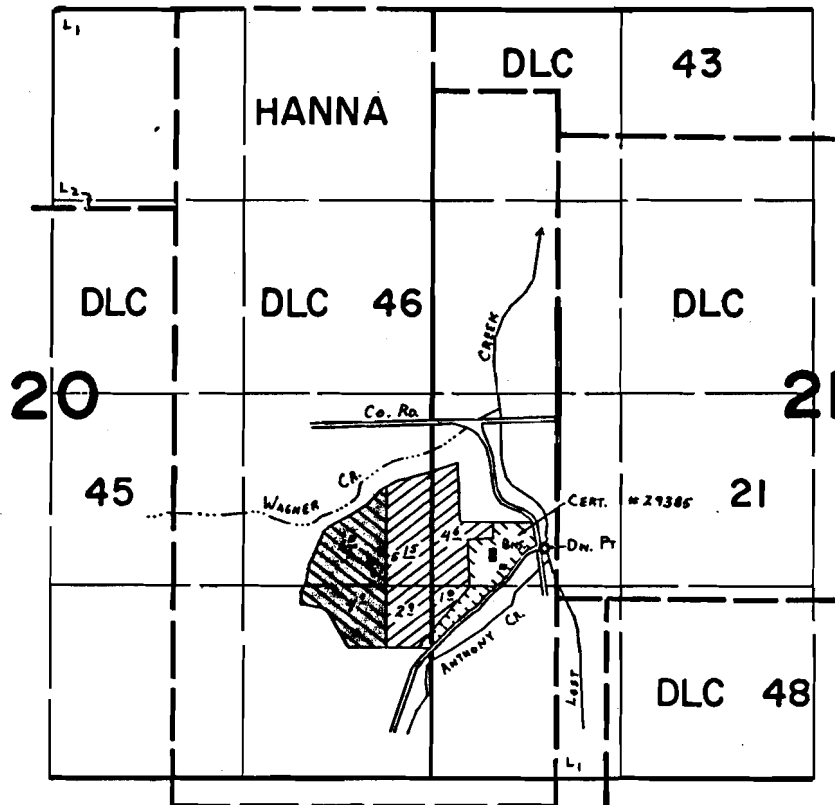

Div. Pt. Loc: 3700'S. & 780' E. fr. N.W. Cor. SEC. 21.

FINAL PROOF SURVEY UNDER

Application No. 61651 45740
52269 Permit No. 39333
IN NAME OF

WILLIAM A. MILLER

Surveyed JULY 19 1978 by C. L. HUGHES
Aug 3 1982 L. M. TOLL