


T.10S., R.5W., W.M.

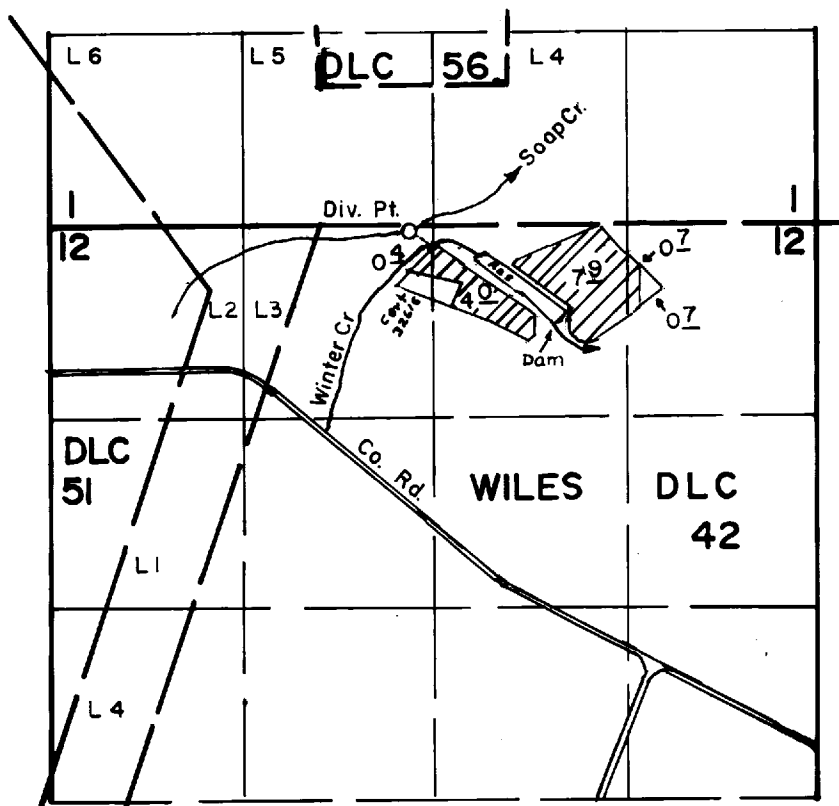

Div. Pt. Located 50'S. & 2500'E., Dam Located 700'S. & 3500'E. Both From N.W. Corner Section 12

SCALE: 1"=1320'

FINAL PROOF SURVEY UNDER

R- 58124

R- 7777

58125

43819

Application No. 59272... Permit No. 44522.....

IN NAME OF

.....**WINTER CREEK INC.**.....

Surveyed **JUNE 6, 1987**, by **B.W. BISHOP**.....