


T. 19 & 20 S. R. 1 W. W.M.

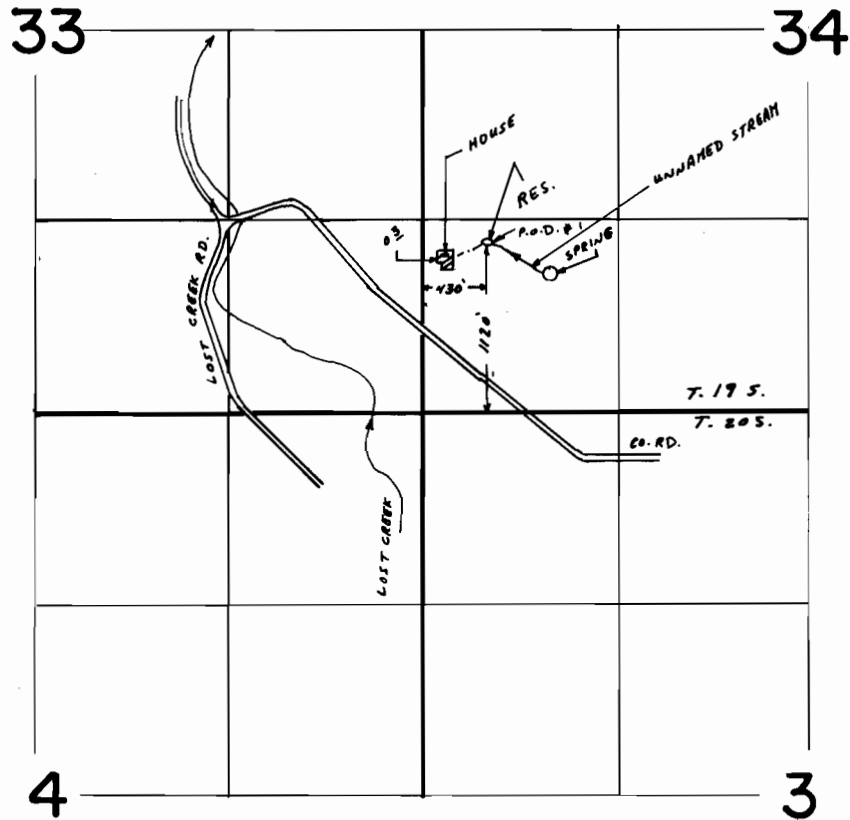

FINAL PROOF SURVEY
UNDER

R-56609

R-7927

Application No. **56610** Permit No. **44393**

IN NAME OF

MARY C. ROBERTS

Surveyed **MAY 25 1988**, by **Z. SALEH**

DBQ-455-99
5-5-89 Z.F.B.