


# T14S, R5W, WM

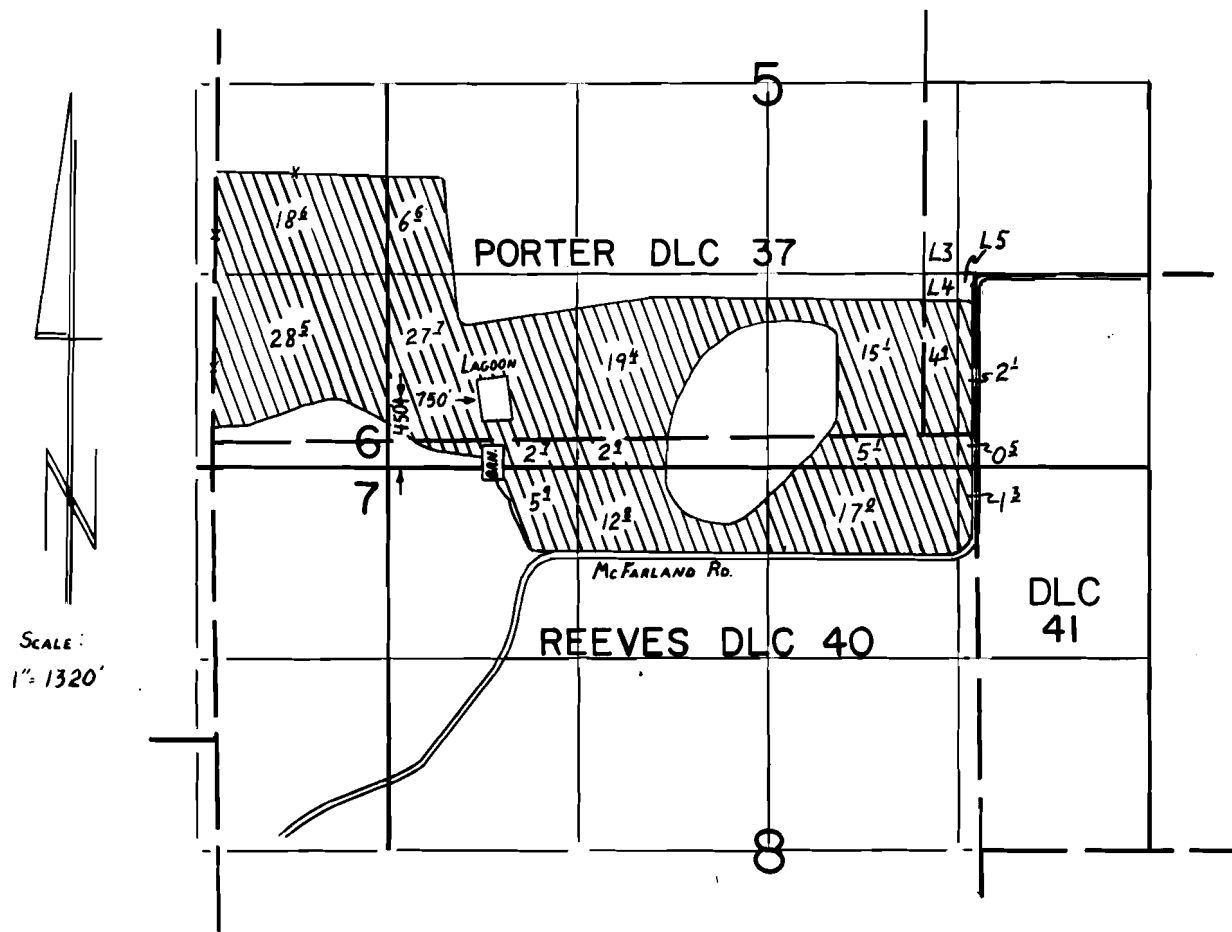

## FINAL PROOF SURVEY UNDER

R-60836                      R-8209  
Application No. 60837... Permit No. 45355.....  
IN NAME OF

.....DONALD W. RANDALL.....

Surveyed NOV... 1987., by T. M. WARREN....