


T. 25 S., R. 5 W., W. M.

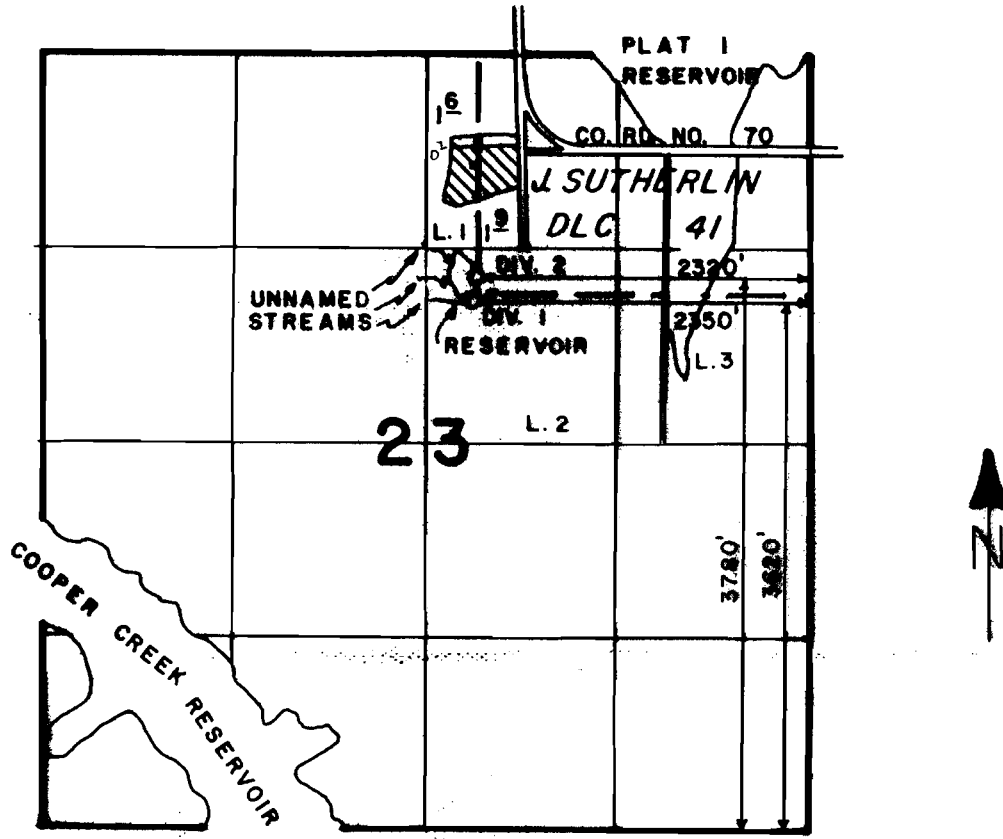

SCALE: 4" = 1 MILE

FINAL PROOF SURVEY
UNDER

R-61443 R-8339
Application No. 61444 Permit No. 46375
IN NAME OF

.....WAYNE S. RADER.....

Surveyed JUNE 11 1987, by J. M. SCHMORDE