


Copy
from
A-11-3

T. 6 S., R. 4 W., W. M.

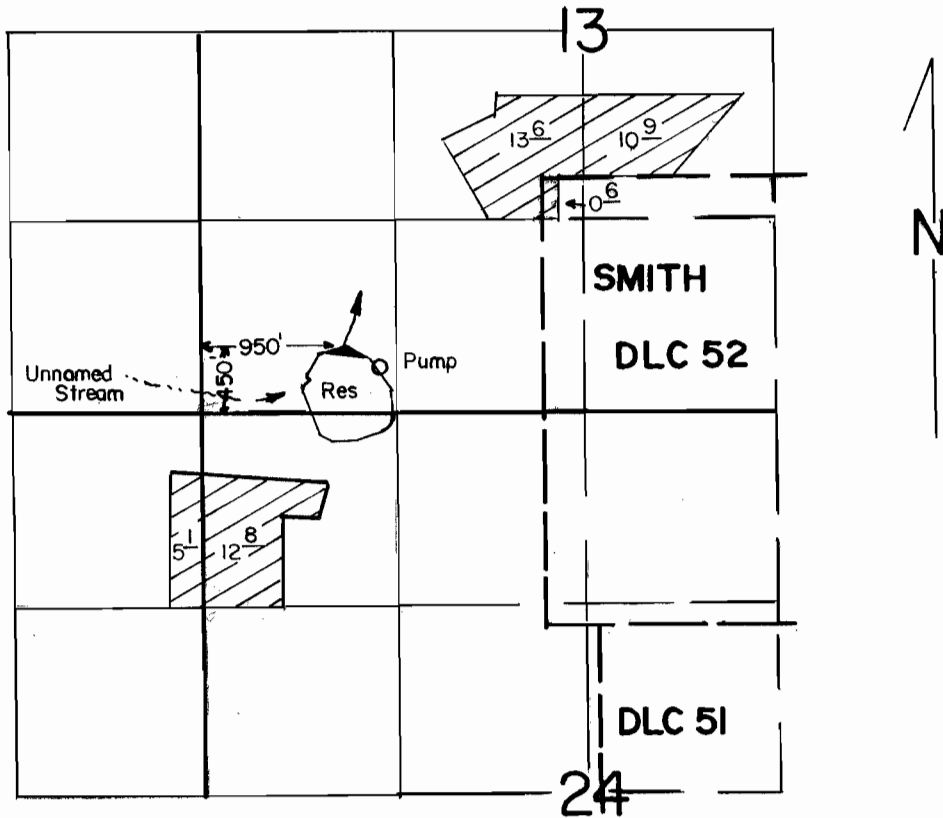

SCALE: 1"=1320'

FINAL PROOF SURVEY
UNDER


R -68102 R -9965
Application No. 68103 Permit No. 48639

IN NAME OF

JAMES RIVER CORP.

Surveyed JUNE 17, 1987, by B.W. BISHOP

T6S, R4W, WM

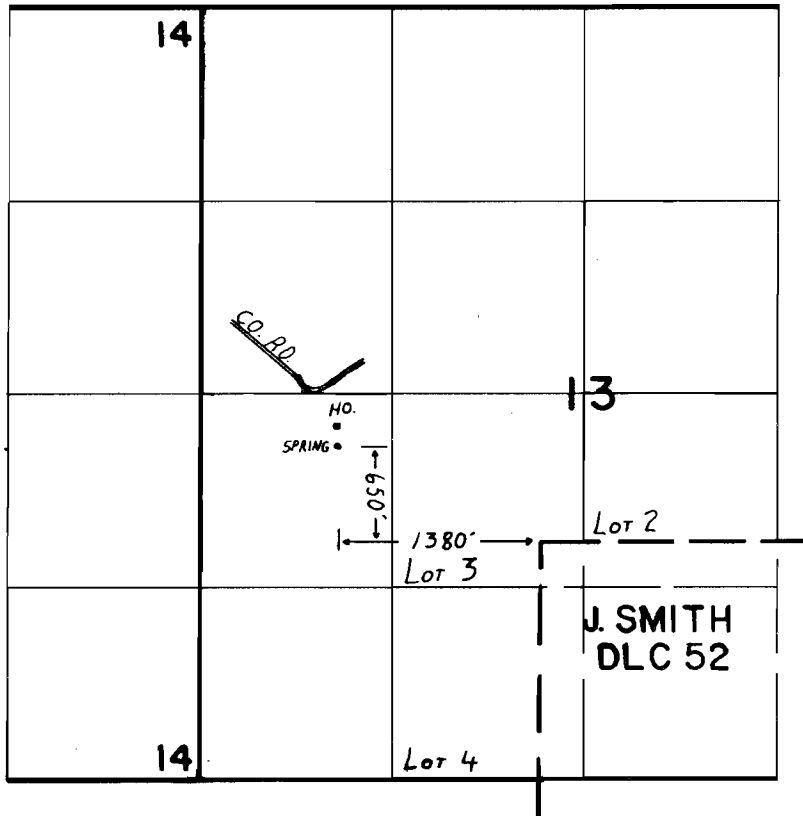

FINAL PROOF SURVEY UNDER

Application No. 68961 Permit No. 49883
IN NAME OF

GEORGE & CLARA SCHROEDER

Surveyed APRIL 29 1987, by B.W. BISHOP