


T. 6 S., R. 4 W., W. M.

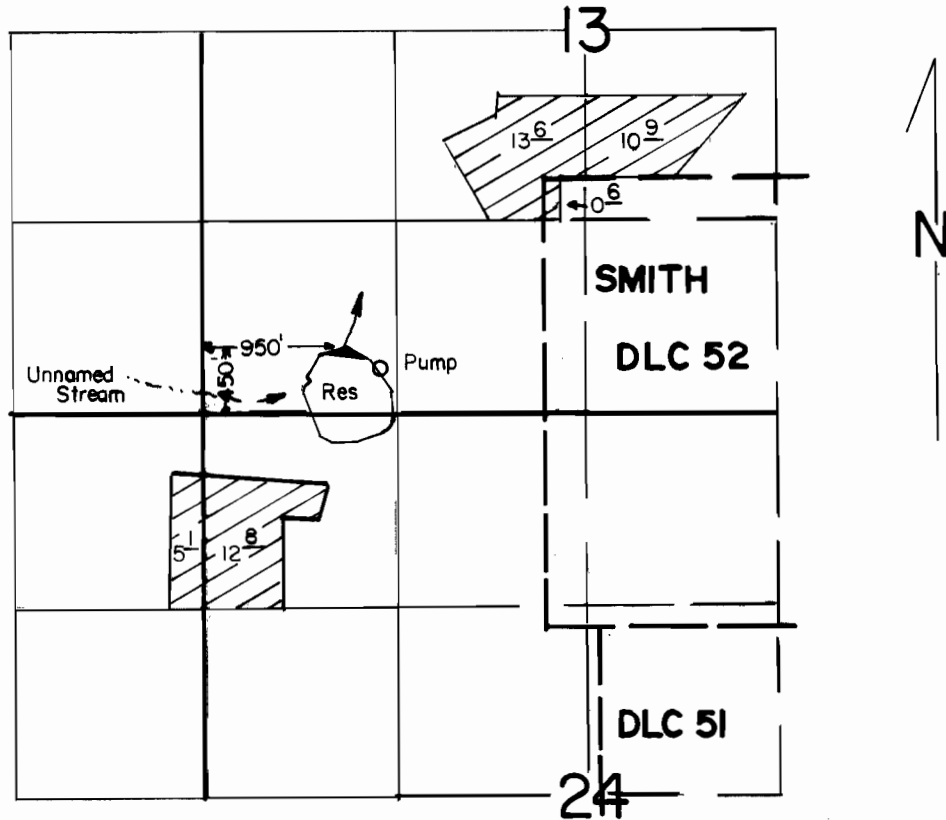

SCALE: 1"=1320'

FINAL PROOF SURVEY
UNDER

R -68102 R -9965
Application No. 68103..... Permit No. 48639.....
IN NAME OF

.....**JAMES RIVER CORP.**.....

Surveyed JUNE 17 1987, by B.W. BISHOP