



T. 10S., R. 40E., W.M.

T. 9S., R. 40E., W.M.

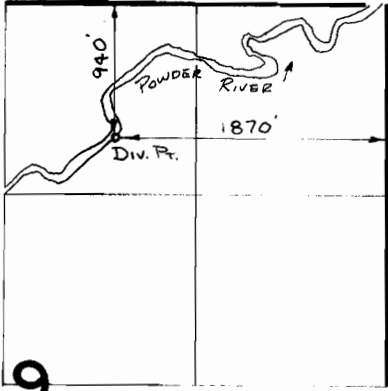

19

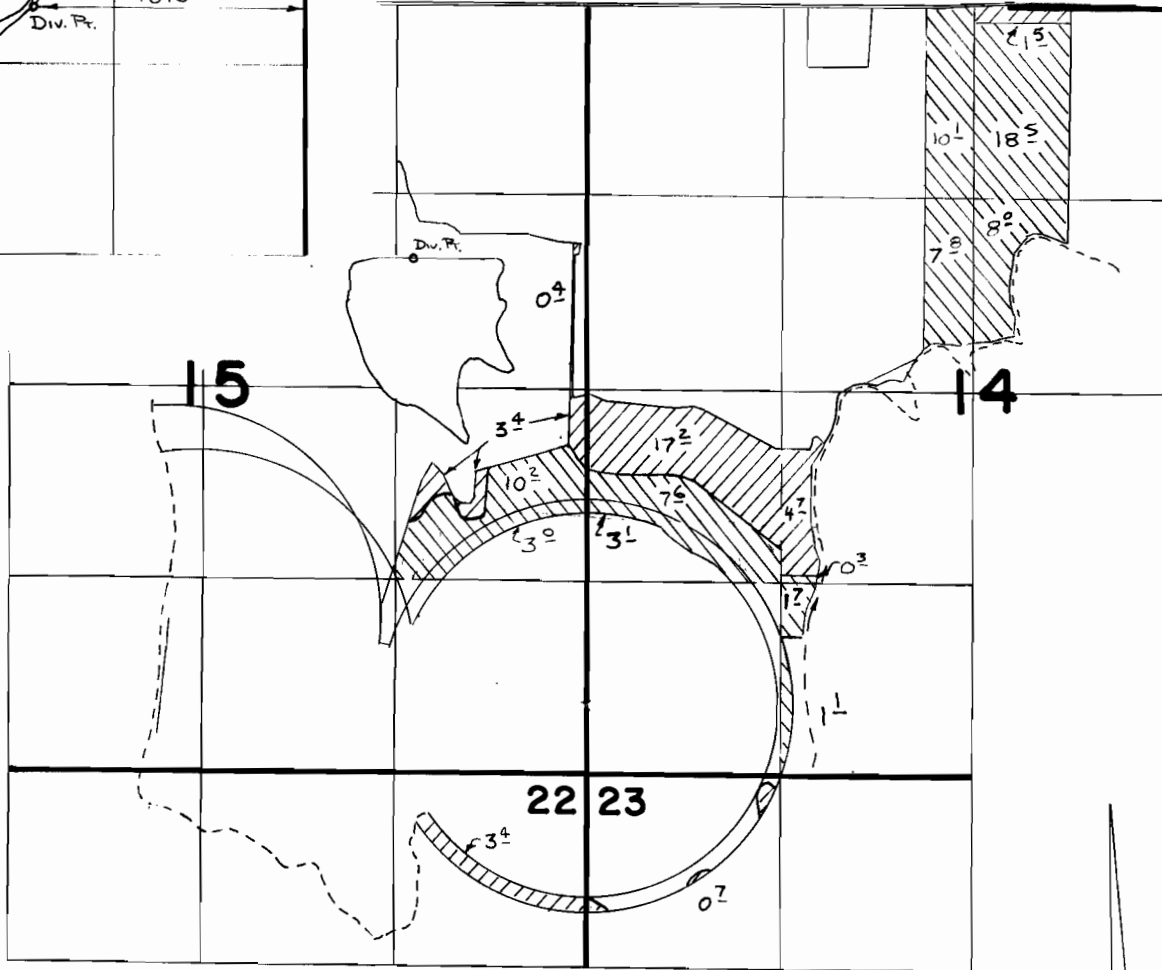

Div. Pt. (SMITH RES) 1750'S. & 1200'W. FROM NE COR SEC 15



PRIM



SUPPL



FINAL PROOF SURVEY
UNDER

SCALE 1" = 1320'

R-68328

R-10510

Application No. **68329** Permit No. **49402**

IN NAME OF

JOHN BOOTSMA

Surveyed 5-17 1988, by V.L. Church