


T.16S.,R.3W.,W.M.

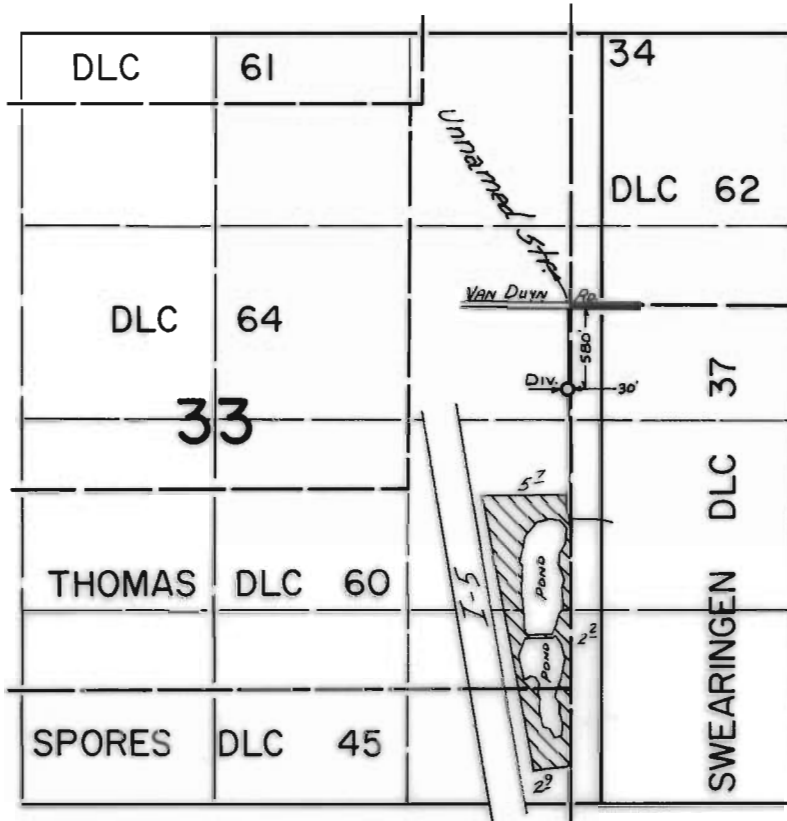

FINAL PROOF SURVEY UNDER

Application No. 49821.. Permit No. 37481.....
IN NAME OF

VIRA CORPORATION/BANDAC

Surveyed June 15 1982, by L.M.TOLL.....