
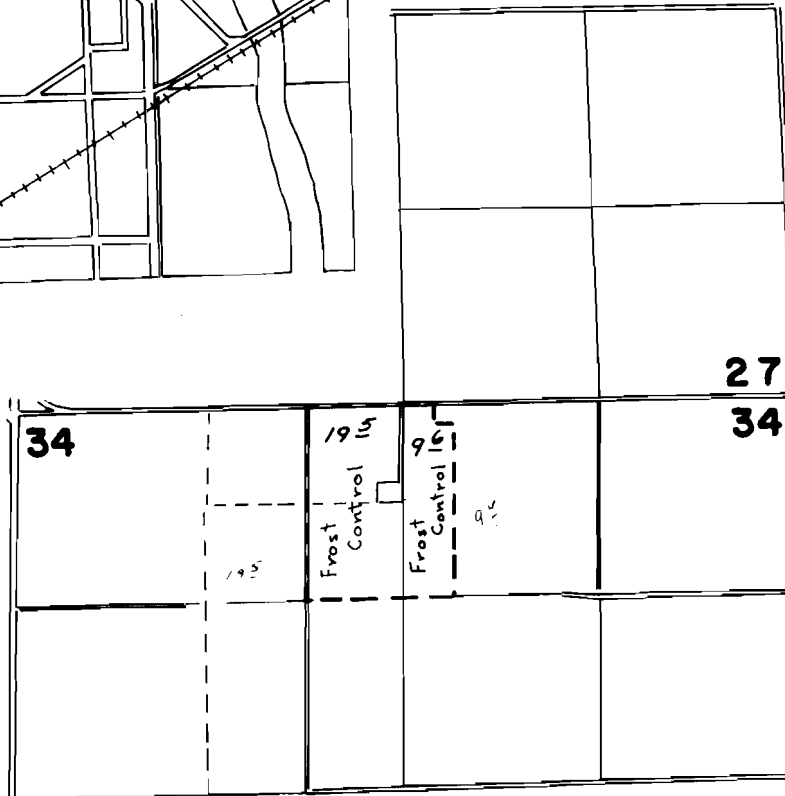


T.6N., R.35E., W.M.

T. 5N., R. 35E., W.M.

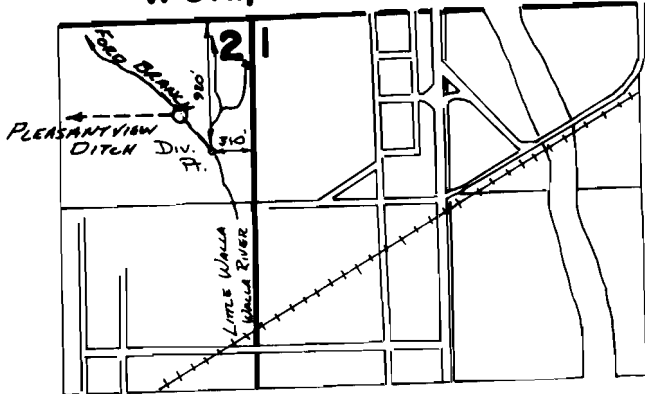

SCALE: 1" = 1320'

FINAL PROOF SURVEY UNDER

Application No. **52224** Permit No. **39314**
IN NAME OF

JAMES A. REESE

Surveyed *4-13* 1984, by *V.L. Church*