




T. 23 S., R. 12 W., W.M.

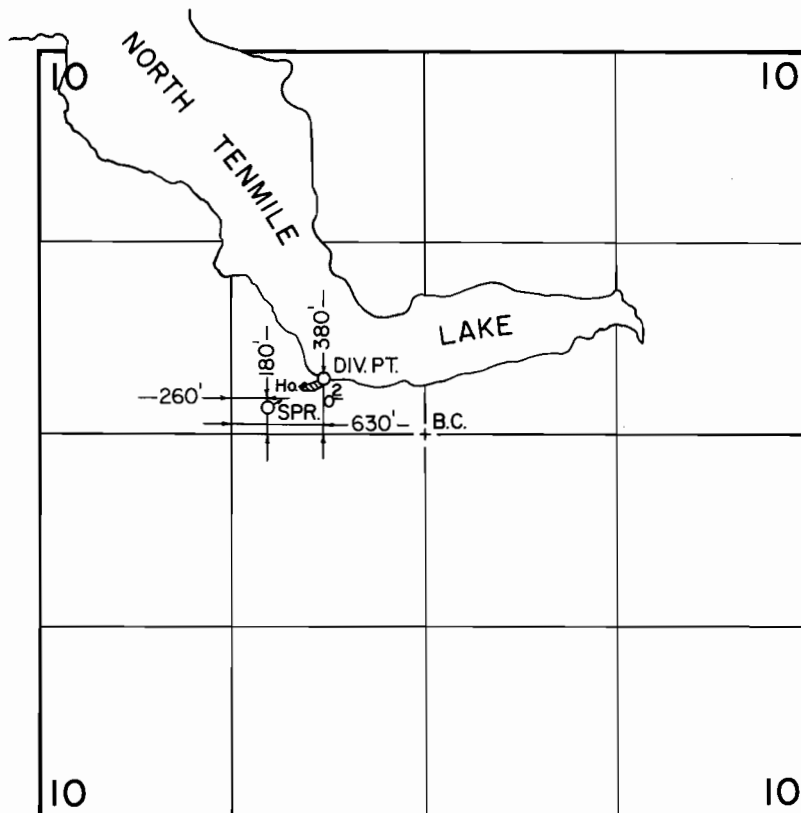

SCALE: 1" = 1320'

FINAL PROOF SURVEY UNDER

Application No. 52414 Permit No. 39424
IN NAME OF

VERA & DELMER L. CROWLEY

Surveyed SEPT. 17, 1988, by T. M. WARREN