
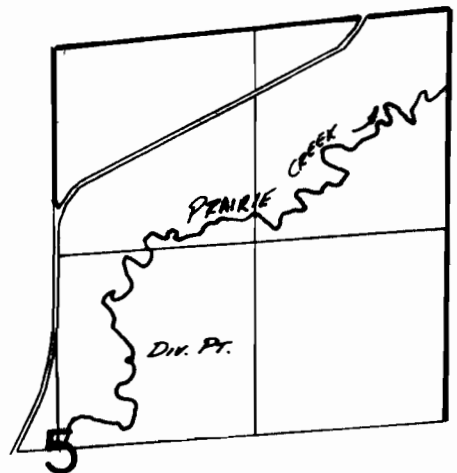


T. 182S., R. 44 & 45E., W.M.

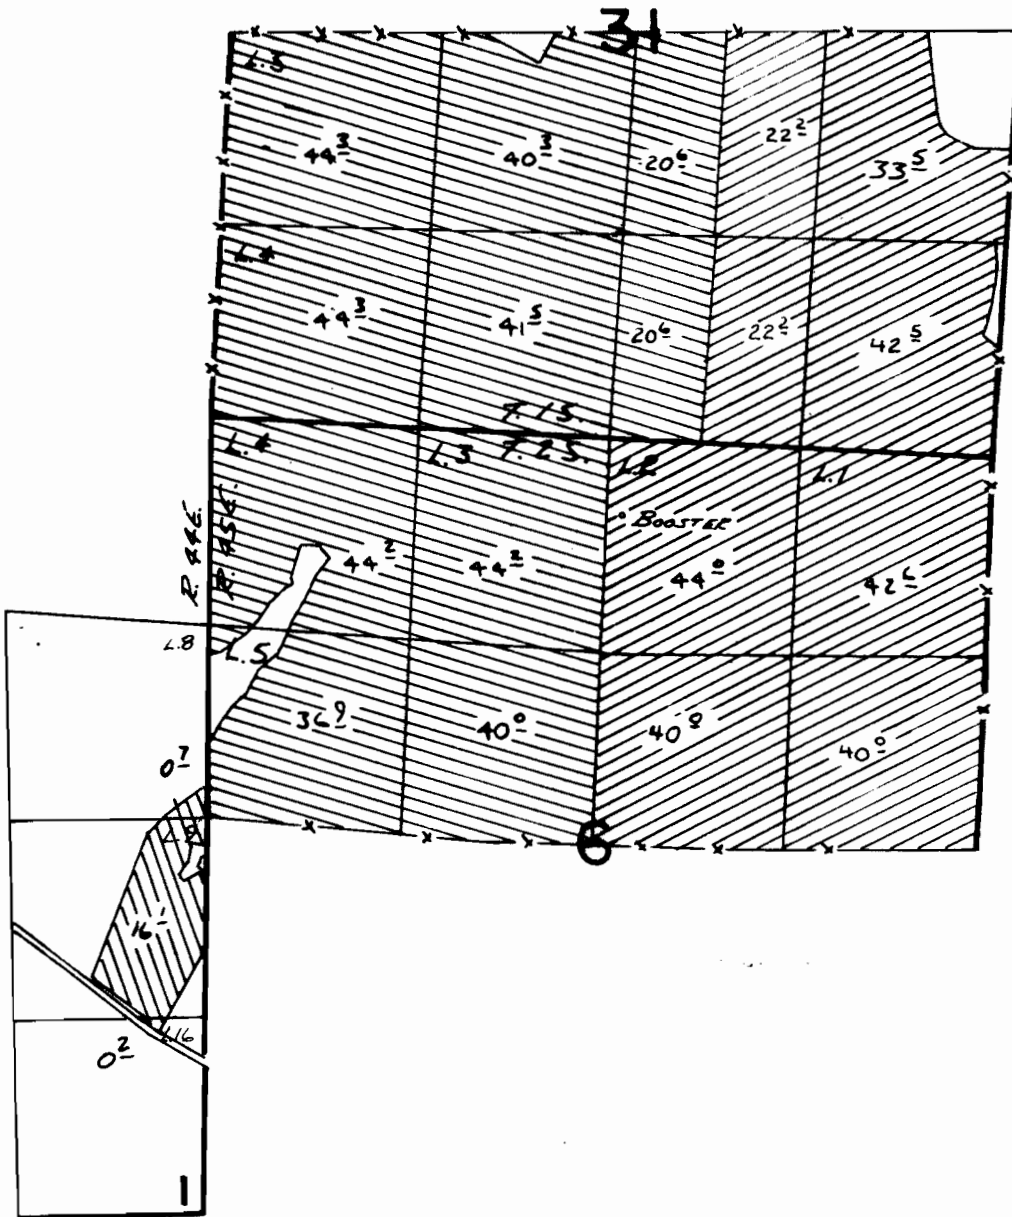

Div. Pt. Loc: 570' N. 500' E. FROM CENTER COR. SEC 5

**FINAL PROOF SURVEY**

UNDER

54170                      40278




61114                      46299

Application No. 54357 Permit No. 40577

IN NAME OF

**TIM J. MELVILLE**

Surveyed 8-11-82 by V. L. Church  
8-6                      84

-  PER. 40577
-  PER. 46299
-  PER. 40278