90684

T. 28 S., R. 11 W., W.M.

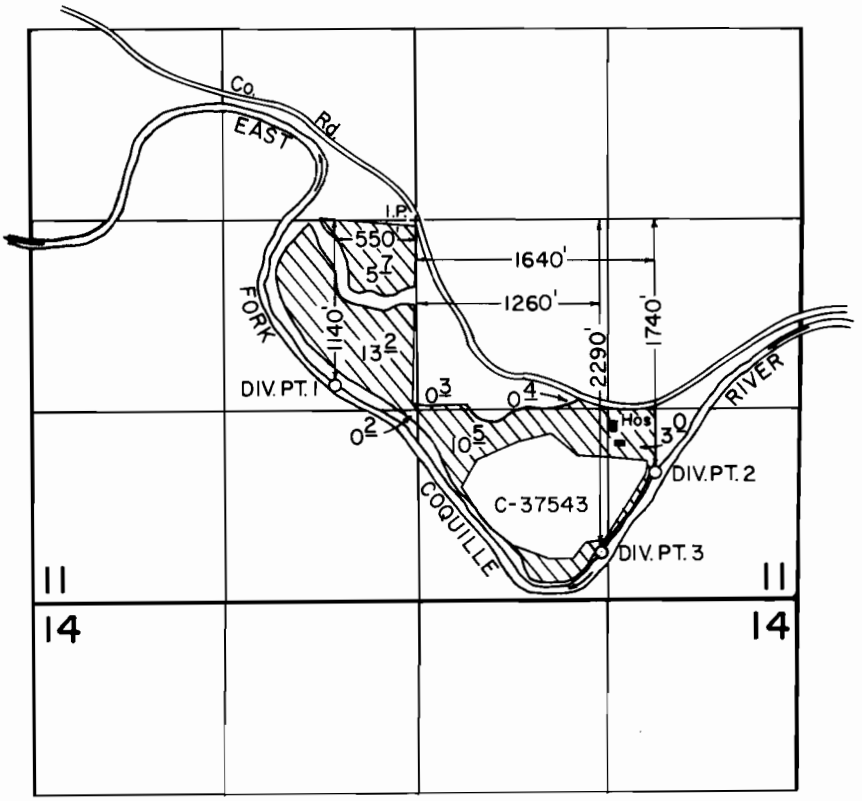

SCALE: 1" = 1320'

FINAL PROOF SURVEY
UNDER

Application No. 53983 Permit No. 40405
IN NAME OF

WILLIAM S. ROBINSON

Surveyed SEPT. 17 1988, by B. S. JAMES

3-2-89
41011-280-49R