


T2N, R10W, WM

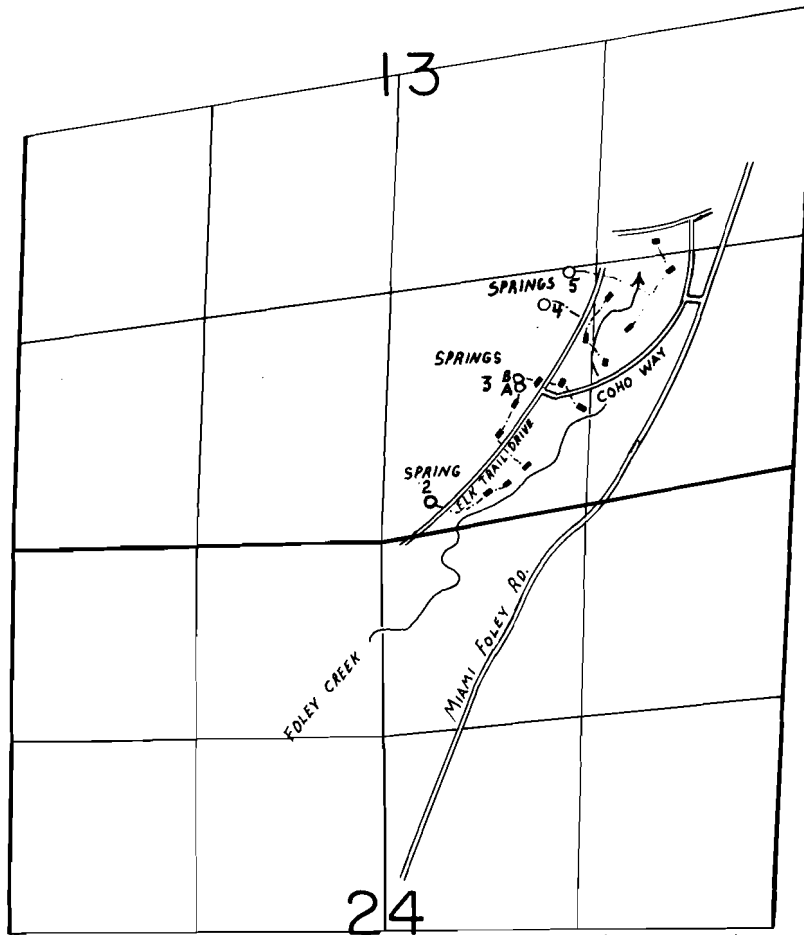

SCALE
1" = 1320'

SPRING LOCATIONS: #2-270' N @ 340' E; #3A-1030' N @ 950' E; #3B-1100' N @ 950' E; #4-1600' N @ 1130' E; #5-1810' N @ 1310' E;
ALL FROM THE S $\frac{1}{4}$ CORNER SECTION 13

FINAL PROOF SURVEY UNDER

■ HOUSES
--- Approx Pipe Loc.

Application No. 54070 Permit No. 40486...
IN NAME OF

FOLEY CREEK DEVELOPEMENT INC.

Surveyed SEPT. 29, 1987., by T.M. WARREN...