


T.6S., R.6W., W.M.

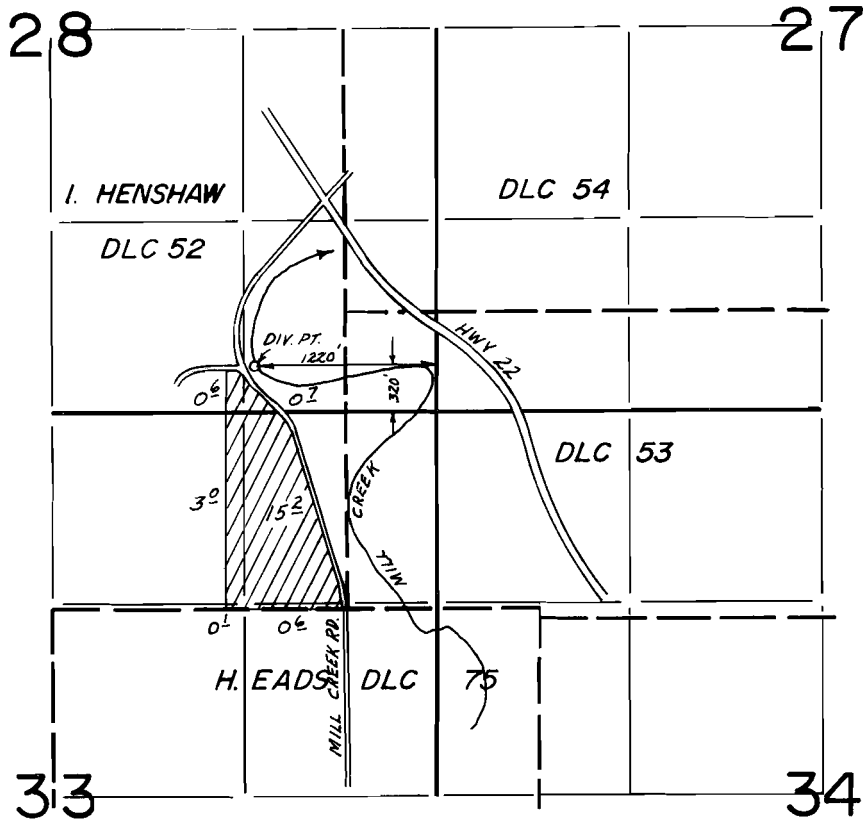

FINAL PROOF SURVEY
UNDER

Application No. 54496.. Permit No. 40872.....
IN NAME OF

KEN CRUICKSHANK

Surveyed MAY 30.. 1979.., by R.G. MUCKEN.....