


T.14S., R.5W., W.M.

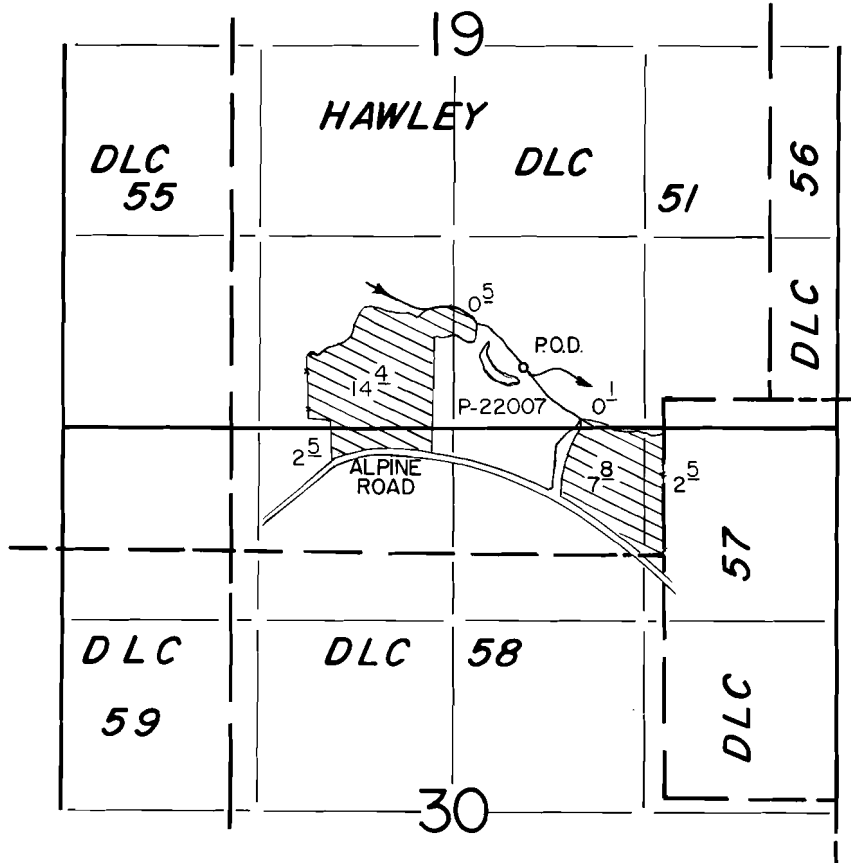

P.O.D. Loc. : 1280' N. & 950' W. from SLYSE Cor DLC 51.

Scale: 1" = 1320'

**FINAL PROOF SURVEY**  
UNDER

Application No. 54637.. Permit No. 40991.....  
IN NAME OF

**RUDOLF & EVELYN BEILICKE**

Surveyed DEC. 1. 1987, by T. Warren.....