


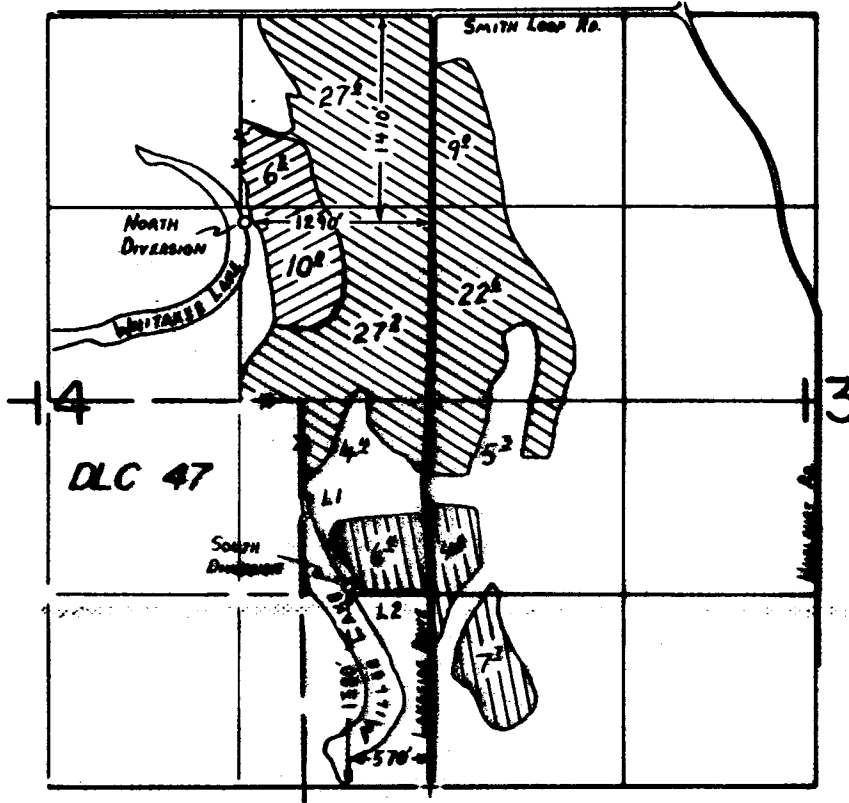


T13S, R5W, WM



-  SOUTH DIVERSION
PRIMARY IRRIGATION
-  NORTH DIVERSION
PRIMARY IRRIGATION
-  NORTH DIVERSION
SUPPLEMENTAL IRRIGATION

FINAL PROOF SURVEY
UNDER

Application No. 55503. Permit No. 41870.....
IN NAME OF

.....CARL LOVELADY.....

Surveyed NOV...19. 1987., by J.M...WARREN..

RVR
41003 178 46R