


T. 15S., R. 5W., W.M.

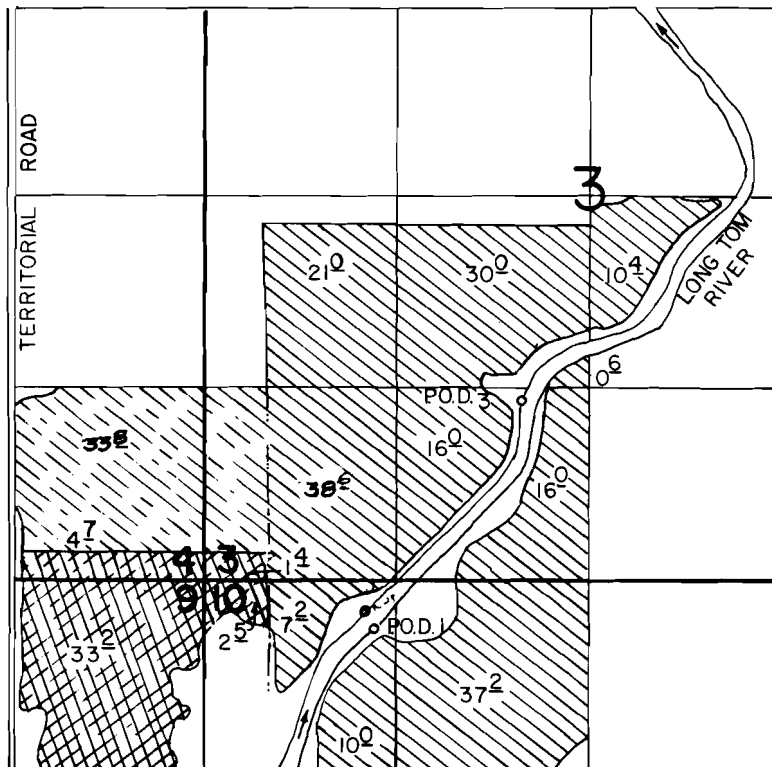

Note : All lands east of river irrigated from P.O.D. 1. All lands west of river from P.O.D. 3.



BOB STRODA
OWNERSHIP



DENNIS STRODA
OWNERSHIP

P.O.D. 1 Loc. : 340' S. & 1470' W.


P.O.D. 3 Loc. : 1240' N. & 460' W., both from S. 1/4 Cor. Sec. 3.

Scale: 1" = 1320'

FINAL PROOF SURVEY

UNDER

Transfer 3780

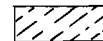

Application No. 55601 Permit No. 42116


IN NAME OF

DENNIS & JENNIE STRODA & BOB STRODA

Surveyed Oct. 28, 1987, by T. Warren



PRIMARY

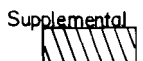

Supplemental