


**T.25S., R.5W., W.M.  
SECTIONS 6 & 7**

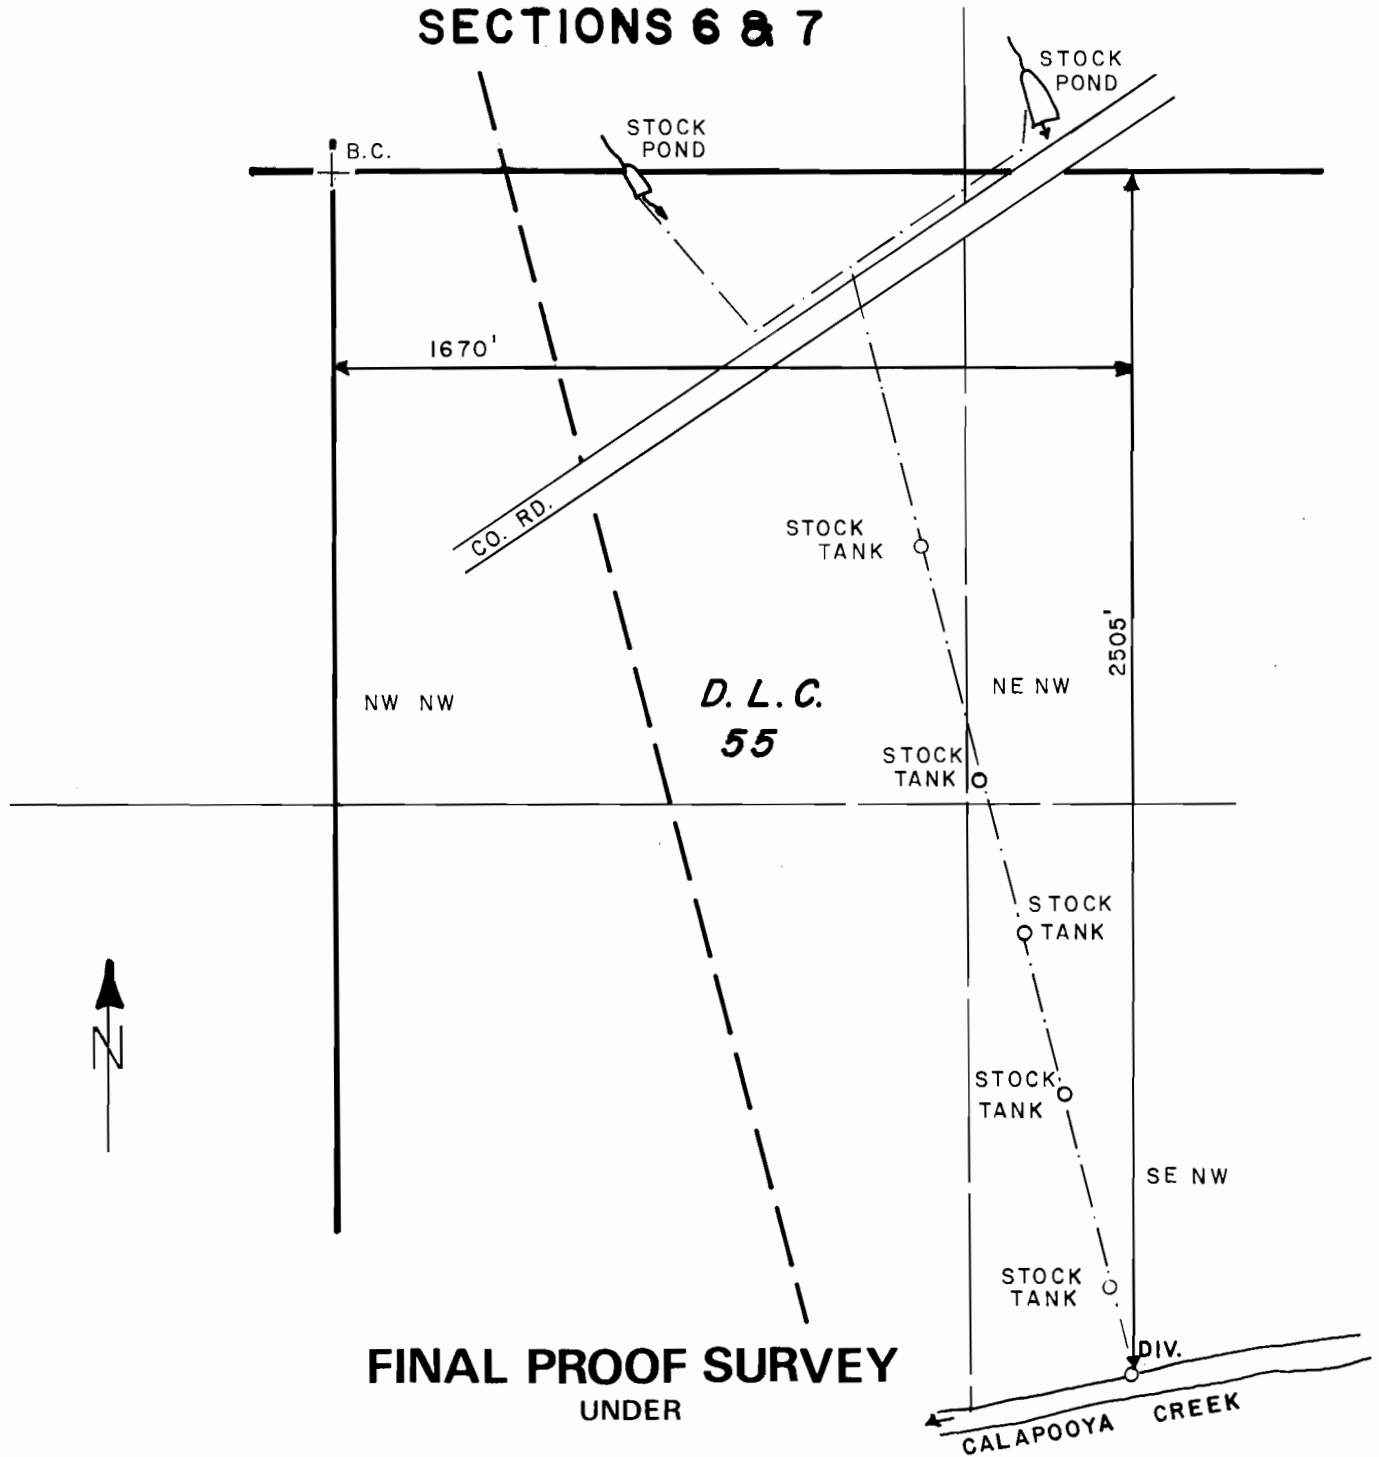

**FINAL PROOF SURVEY  
UNDER**

Application No. 56335 Permit No. 42150  
IN NAME OF

DONALD BARRETT

Surveyed JULY 1, 1986, by J. M. SCHMORDE

*ACC' = 1"*