


T.7S., R.38E., W.M.

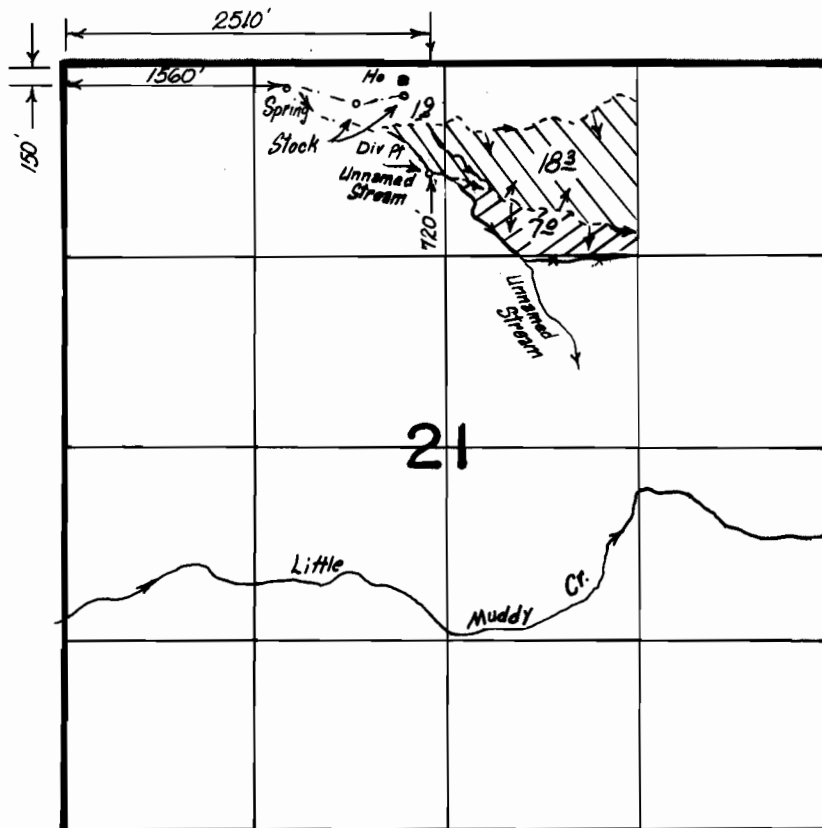

Scale: 1" = 1320'

FINAL PROOF SURVEY

UNDER

Application No. 56544 Permit No. 42124....
IN NAME OF

GILBERT ELLIOT

Surveyed 6-4-1987, by Vern Church



Spring



Spring &
Unnamed Stream