


T.6S., R.7W., W.M.

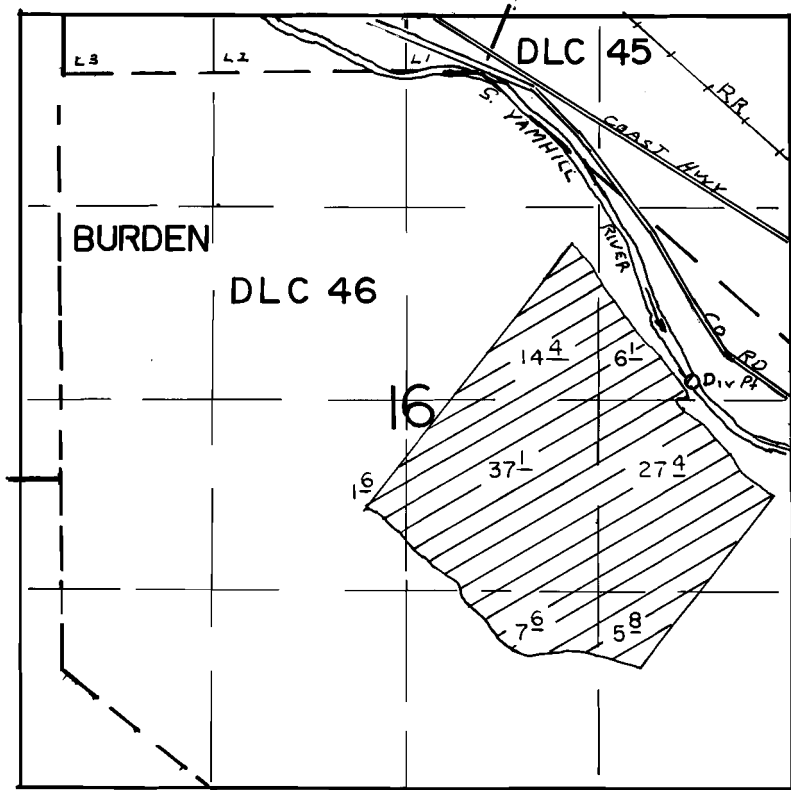

Div Pt Located 120' N & 700' W From E1/4 Section 16

SCALE: 1" = 1320'

FINAL PROOF SURVEY
UNDER

Application No. 57131..... Permit No. 42925.....
IN NAME OF

.....SHENKS DAIRY.....

Surveyed APRIL 21... 1987... by ..B.W.BISHOP.....