


T. 15 S., R. 12 W., W.M.

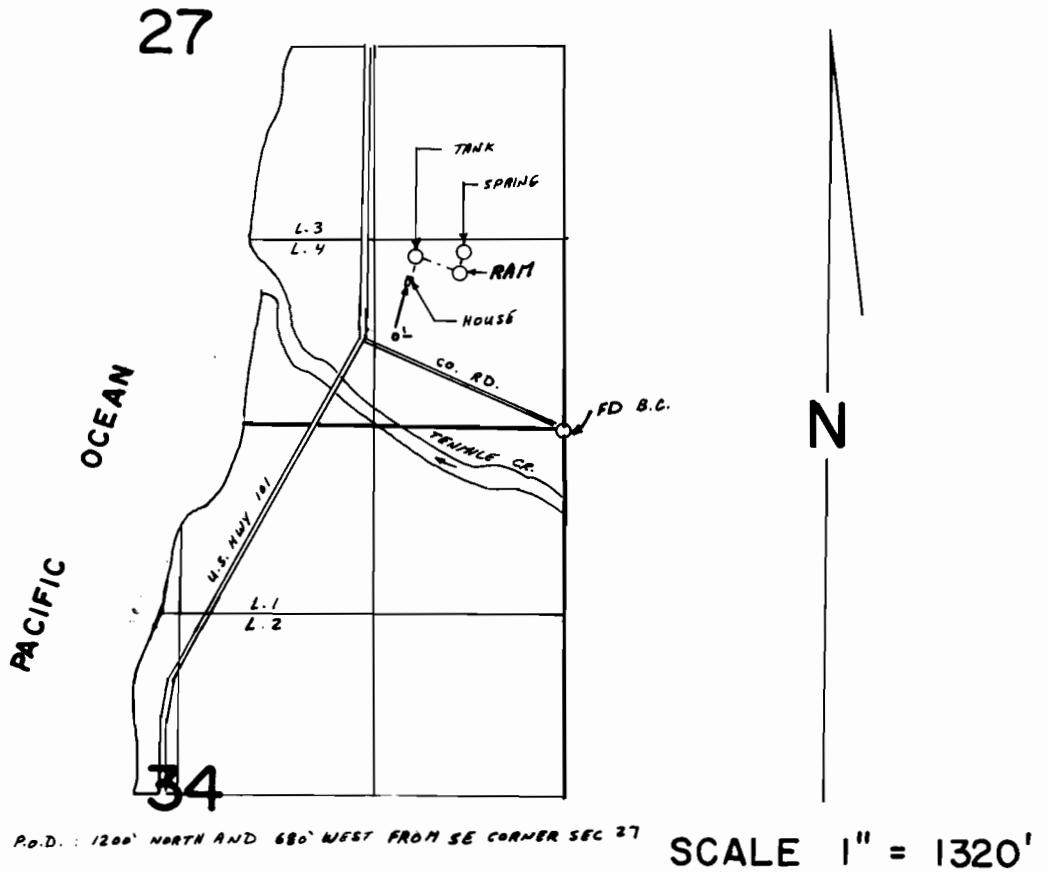

**FINAL PROOF SURVEY**  
UNDER

Application No. 57918 Permit No. 43702  
IN NAME OF  
TOMMY L. SMITH  
Surveyed AUG...11... 1988, by Z....SALEH.....