


T.8S., R.6W., W. M.

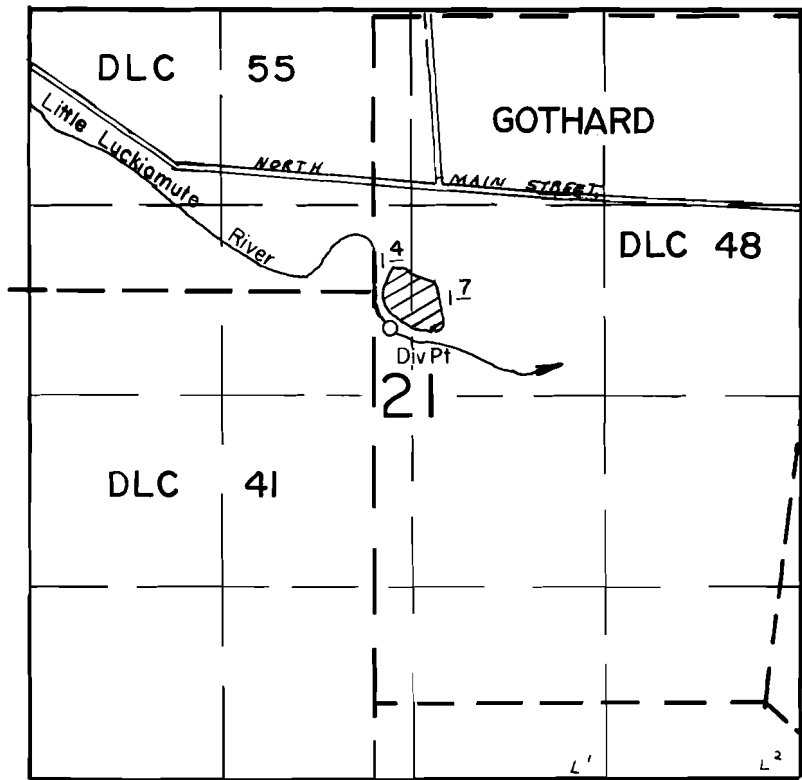

N

Div. Pt. Located 250' S. & 120' E. From SE Corner DLC 55

SCALE: 1" = 1320'

FINAL PROOF SURVEY
UNDER

Application No. 58701..... Permit No. 44193.....
IN NAME OF

FALLS CITY SCHOOL DISTRICT NO. 57

Surveyed JUNE 2... 1987., by B.W. BISHOP.....