


T. 39 S., R. 8 W., W.M.

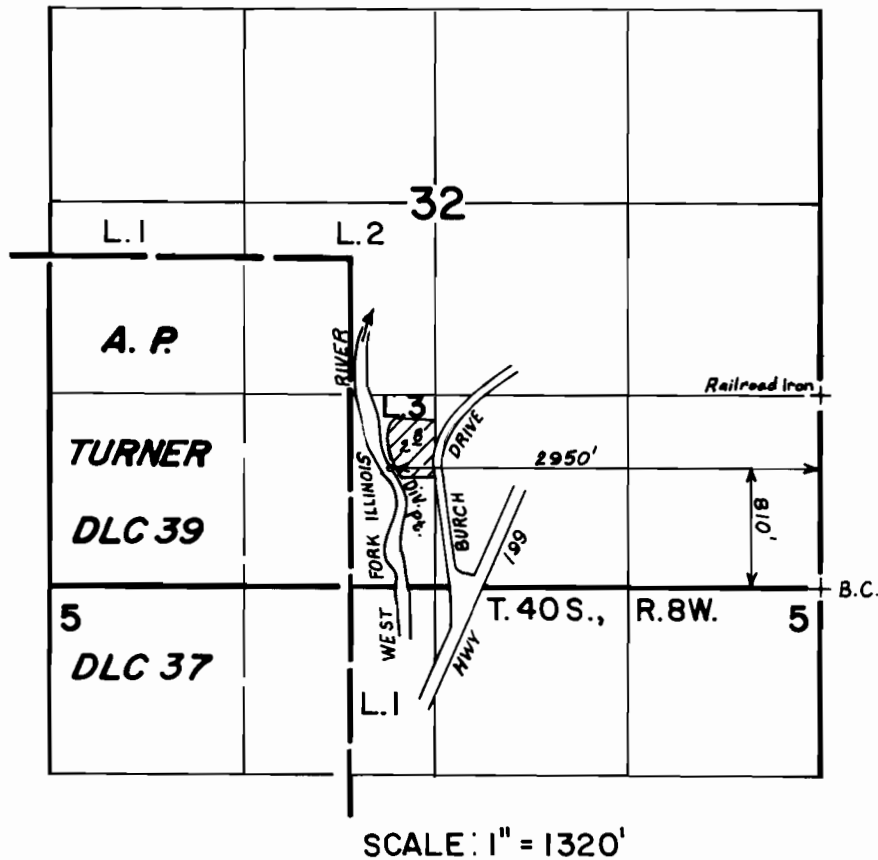

FINAL PROOF SURVEY UNDER

Application No. **60269** Permit No. **45132**.....
IN NAME OF

.....
Surveyed **MAR. 27** 19 **84**, by **B.S. JAMES**.....