
T. 4 N., R. 29 E. W.M.

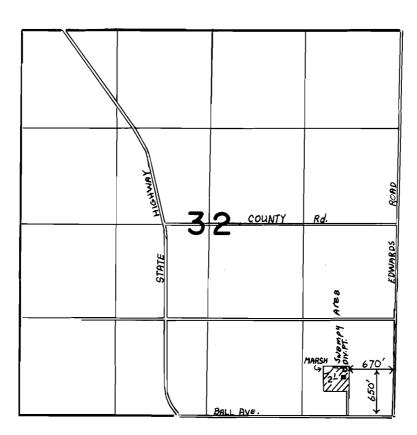



FINAL PROOF SURVEY

UNDER

Application No. .61506... Permit No. ...45800...
IN NAME OF

LUTHER DODSON