

45891


38-5-12

RECEIVED

MAR 23 1984

WM. DIST. 14  
GRANTS PACS. ORE.

# T. 38 S., R. 4 & 5 W., W.M.

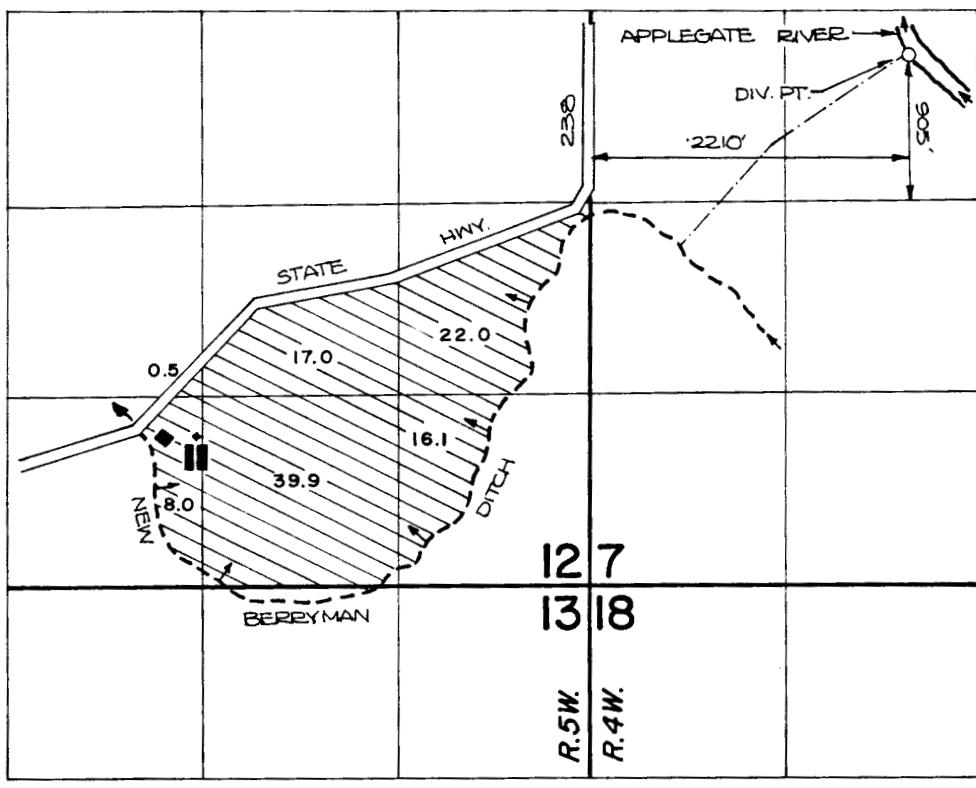

~~FINAL PROOF SURVEY~~  
UNDER

Application No. 61923. Permit No. 45891....  
IN NAME OF

**JOHN AND/OR GERTRUDE SAKRAIDA**

Surveyed AUG. 4. 1983, by B. JAMES.....