


RECEIVED

AUG 3 1981

WATER RESOURCES DEPT  
SALEM, OREGON

T.39S. R.3W. W.M.

Application No. 62055  
Permit No. 45953

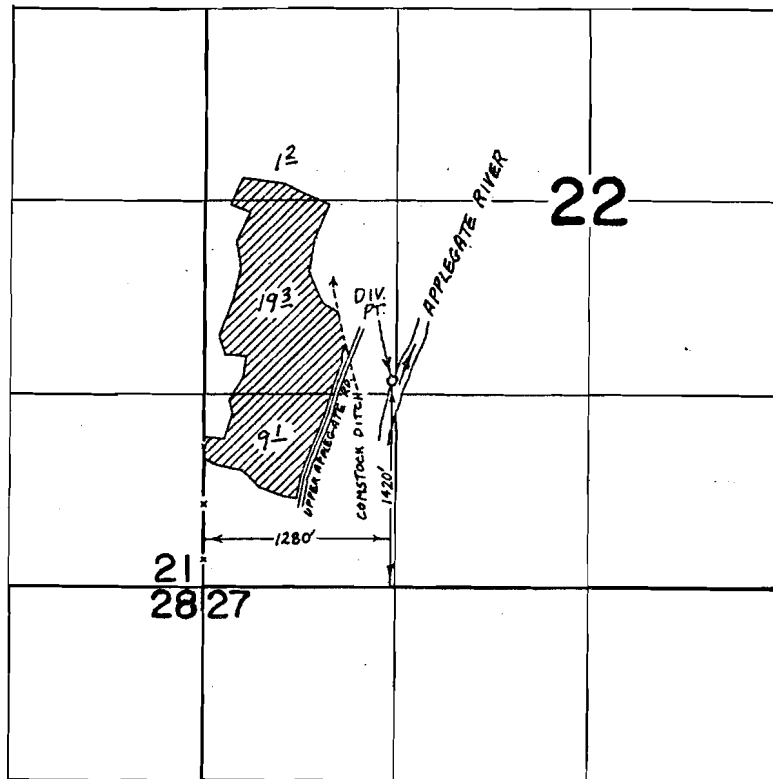

Fred L. and Nancy K. Straube map for application to appropriate stored water from Applegate Lake Res. in amount of 29.6 acre feet to 29.6 acres supplementally irrigate.

FINAL PROOF SURVEY  
UNDER

Application No. 49898 Permit No. 37551  
IN NAME OF

FRED L. OR NANCY K. STRAUBE

Surveyed NOV. 5 1975, by L. TOLL

CERT. NO. 44719  
PRIORITY 12-7-72.