
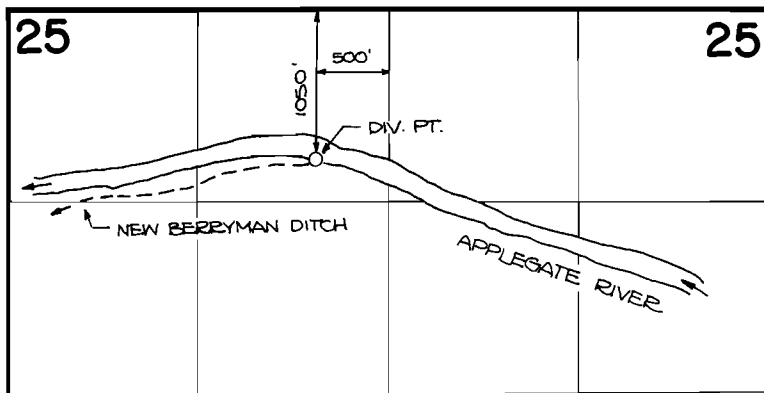


T.38S. R.4W. W.M.

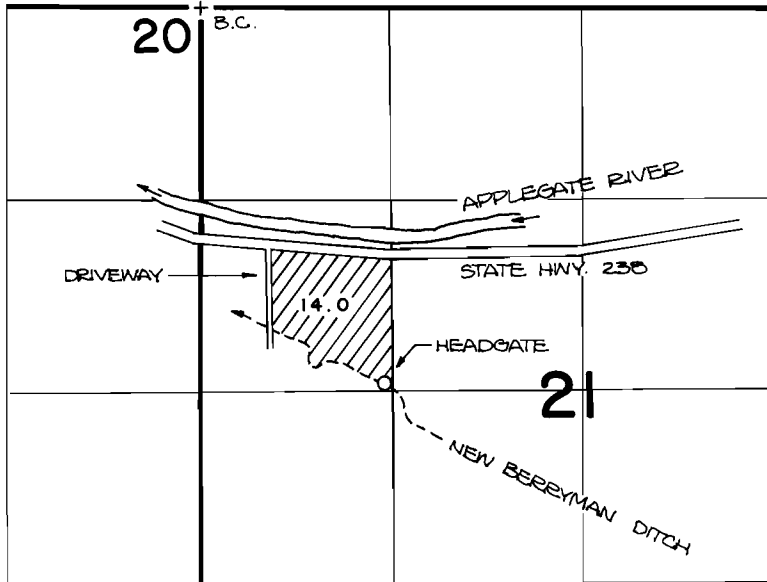

FINAL PROOF SURVEY UNDER

Application No. 62060 Permit No. 45957...
IN NAME OF

.....**MARK INGHAM**.....

Surveyed **JULY 28, 1983**, by **B. JAMES**.....