
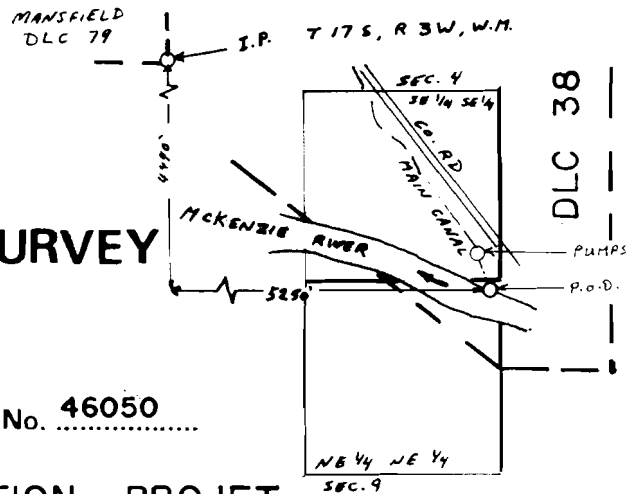


T. 14 S., R. 4 W., W.M.

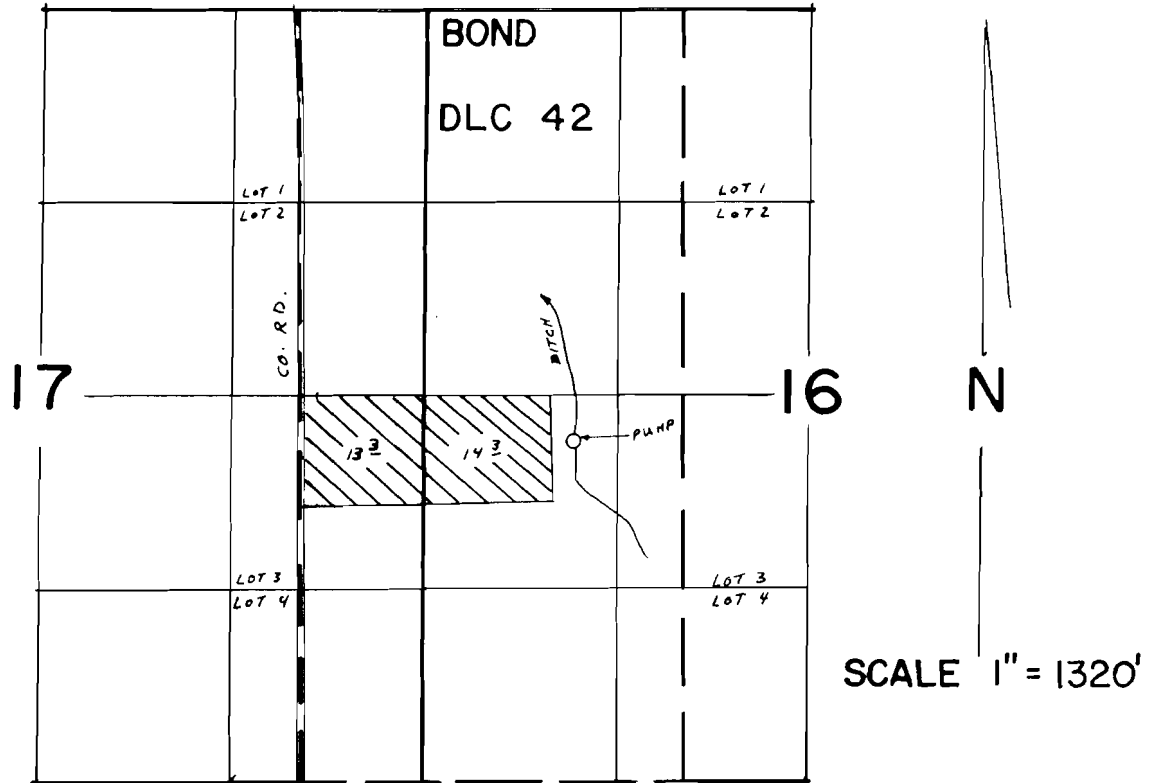

FINAL PROOF SURVEY
UNDER

Application No. **59809** Permit No. **46050**
IN NAME OF

MUDDY CREEKS IRRIGATION PROJCT

Surveyed **MAY 26 1988** by **Z. SALEH**

41043-178-141 D
5-4-89 Z.f.S.