


# T. 37S., R. 6W., W.M.

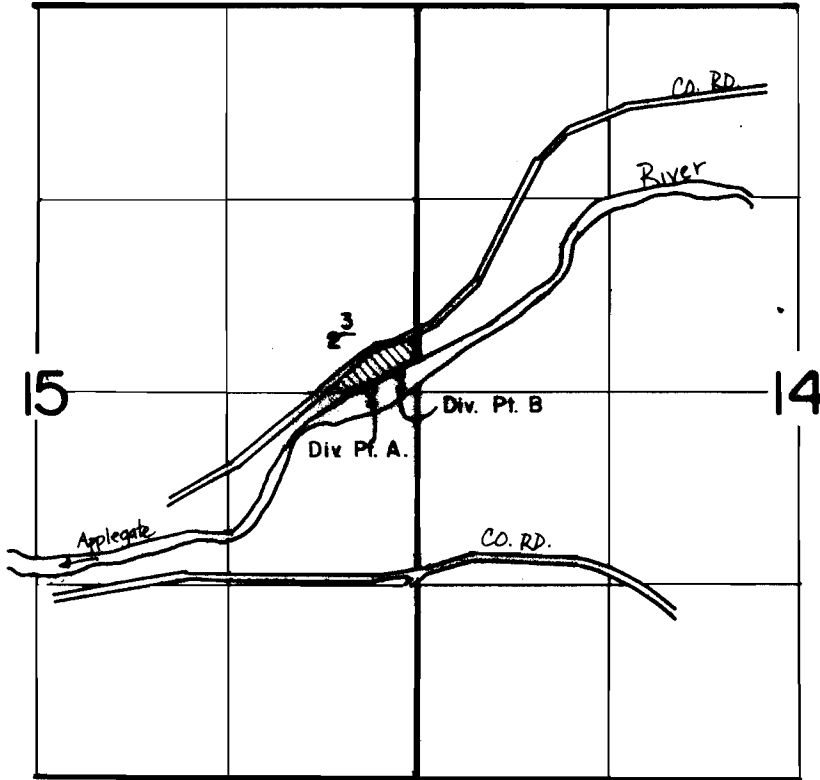

Div. Pt. A located 10' N. & 320' W.; Div. Pt. B located 100' N. & 100' W. both from the East 1/4 Corner, Sec. 15.

## FINAL PROOF SURVEY UNDER

Application No. 62199... Permit No. 46077.....  
IN NAME OF

**LAWRENCE C. HUCK**

Surveyed O.C.T. 19, 1983., by B.S. JAMES.....