


T. 36 S., R. 4 W., W. M.

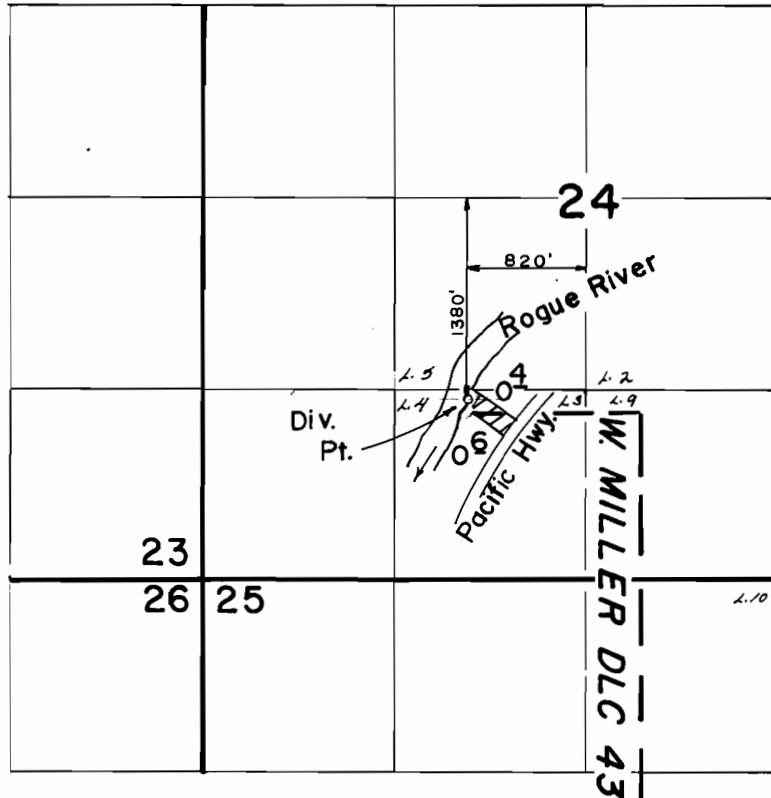

Scale: 1" = 1320'

FINAL PROOF SURVEY
UNDER

Application No. 61027 Permit No. 46206
IN NAME OF

ARDEN M. DIETZ

Surveyed JUL 2 1986, by R. S. JAMES