

RECEIVED

SEP 11 1981

WATER RESOURCES DEPT  
SALEM, OREGON

61991


46307

T.38S.,R.4W.,W.M.

priority

1-3-69

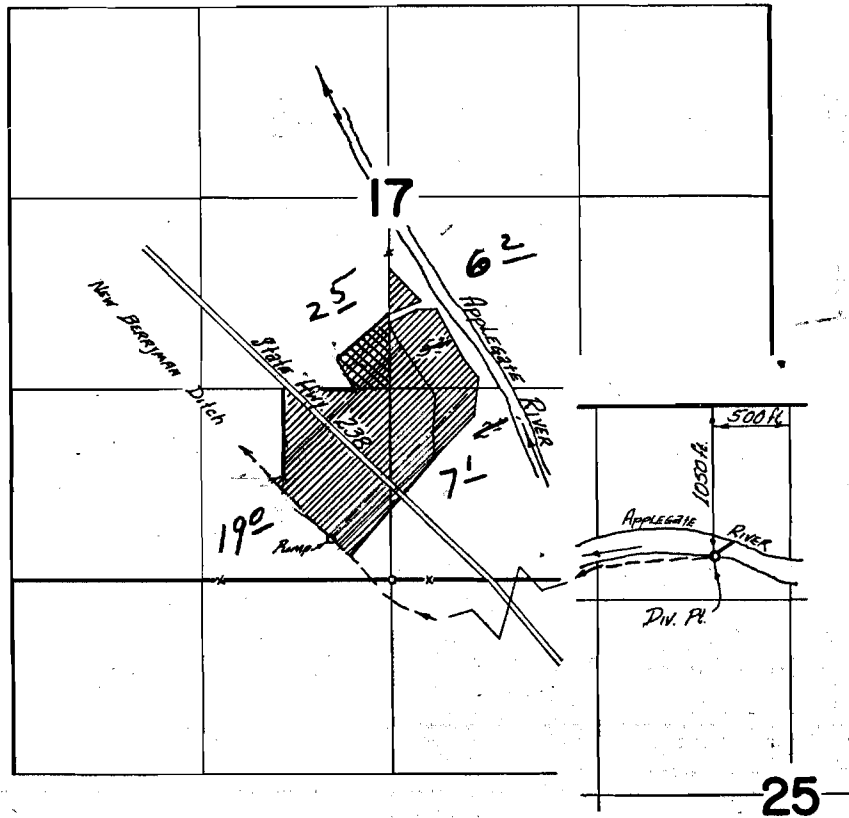

Applegate R.



Map to accompany application of Elden Snyder to appropriate supplemental water from Applegate Lake Reservoir.

**FINAL PROOF SURVEY**

UNDER

 irrigation  
 suppl irrigation

Application No. 45679 Permit No. 34081

IN NAME OF

ELDEN C. SNYDER

Surveyed Oct 10 1973, by D. NORBY