


T.29S., R.5W., W.M.

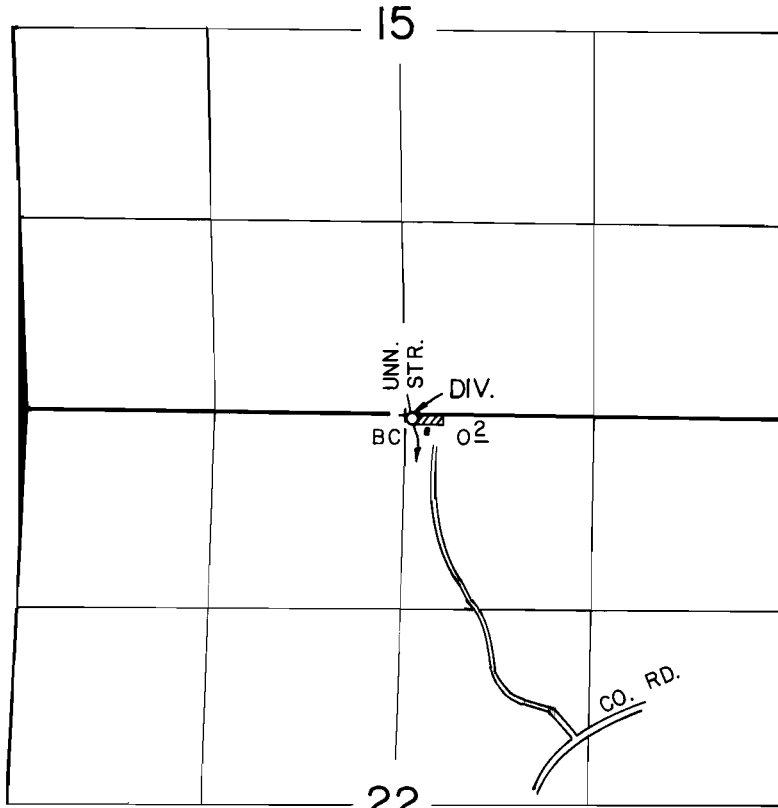

DIV. LOCATION: 30' S. & 50' E. FROM N. 1/4 CORNER
SEC. 22

SCALE: 4" = 1 mile

FINAL PROOF SURVEY
UNDER

Application No. 61334 Permit No. 46336
IN NAME OF

RICHARD L. & KATHLEEN J. MORTON

Surveyed DEC. 13, 1984, by *L. Cashman*