

RECEIVED


AUG. 3 1981

WATER RESOURCES DEPT
SALEM, OREGON

T27S R11W
Section 7
SW $\frac{1}{4}$ SE $\frac{1}{4}$



SCALE:
1" = 200'

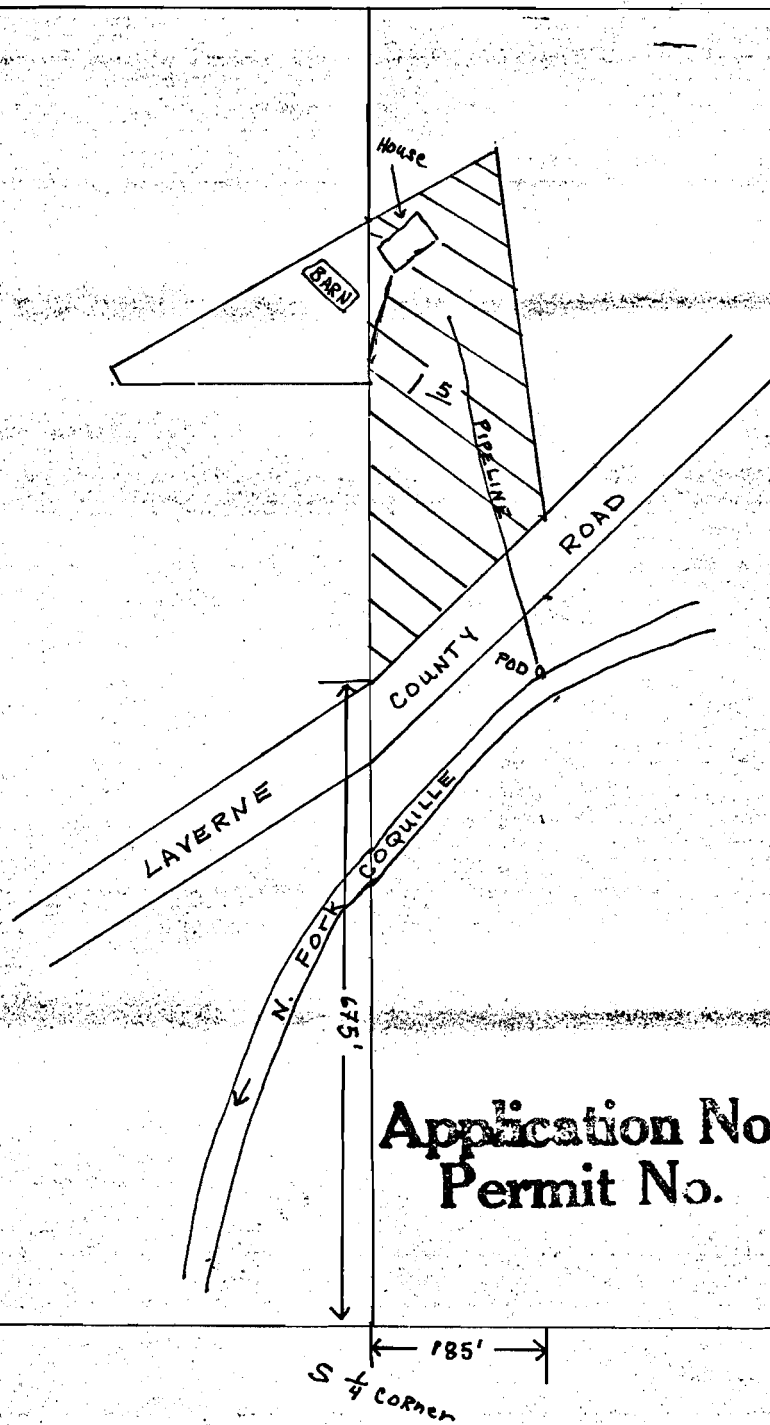

Application No. 62041
Permit No. 46344