


SEC 7 Tp 27S R11WWM

RECEIVED

AUG 3 1981

WATER RESOURCES DEPT.
SALEM, OREGON

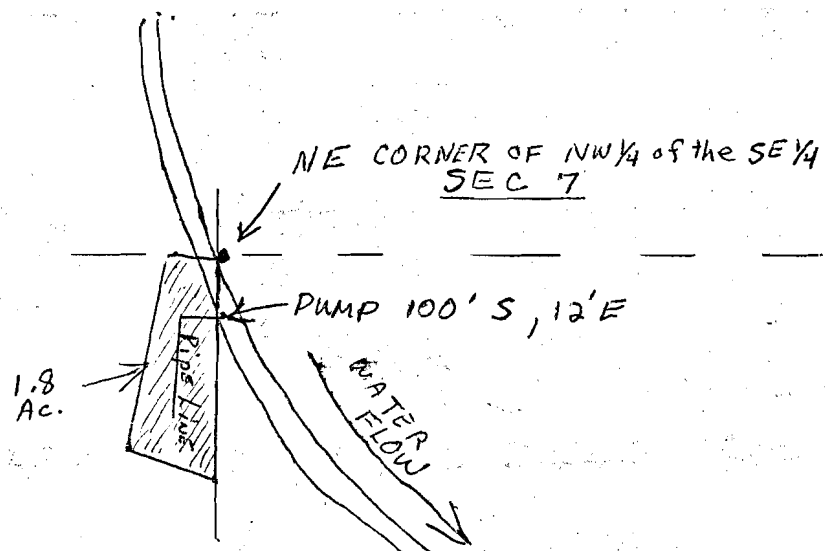

Application No. 62043
Permit No. 46345

7 8

RECEIVED

18 17

DEC 15 1981

WATER RESOURCES DEPT.
SALEM, OREGON