




T.27S.,R.11&12 W.,W.M.

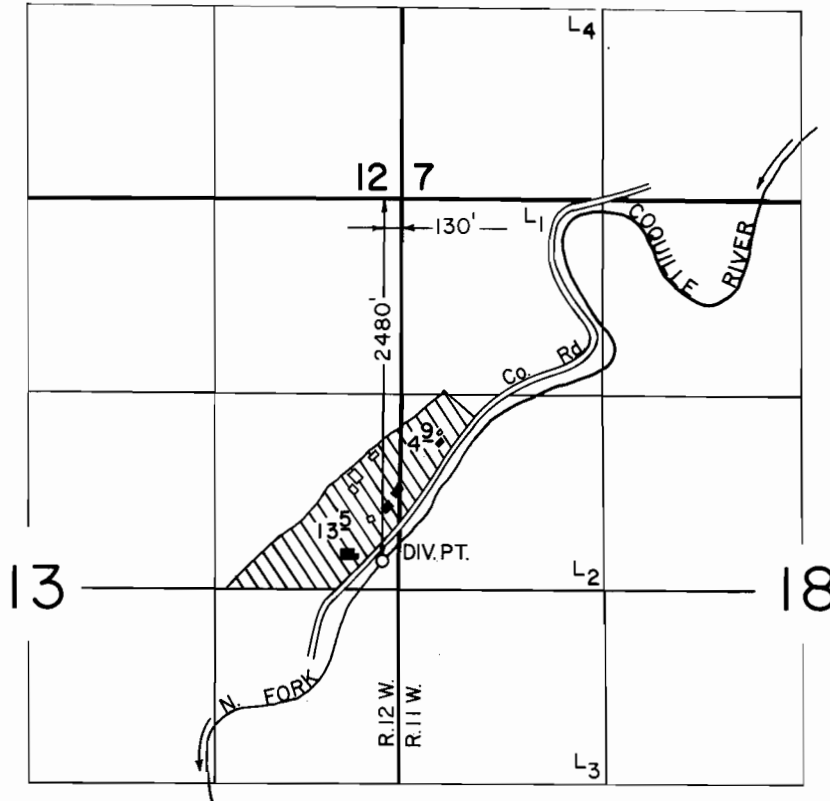

SCALE: 1" = 1320'

FINAL PROOF SURVEY
UNDER

Application No. 62415 Permit No. 46521
IN NAME OF

LELAND W. & GEORGIA GRISHAM

Surveyed SEPT. 20 1988, by Z. SALEH