


T. 36 S., R. 6 W., W.M.

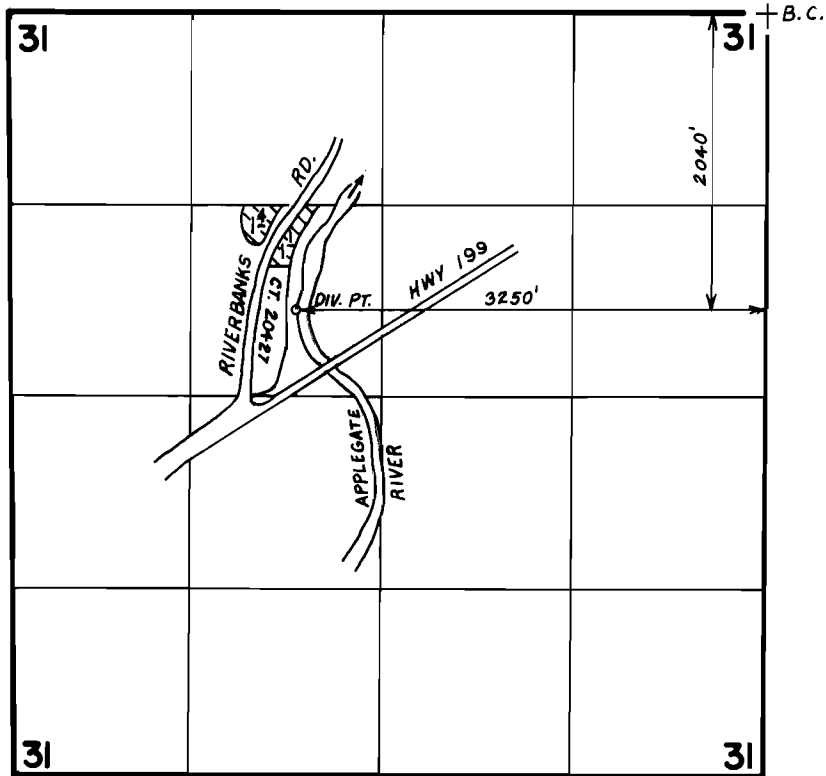

Scale: 4" = 1 mile

**FINAL PROOF SURVEY**  
UNDER

Application No. **62822** Permit No. **46598**...  
IN NAME OF

**CLIFFORD & MARTHA MALLOUF**

Surveyed JAN. 19. 19.84, by B.S. JAMES.....