


T9S, R2E, WM

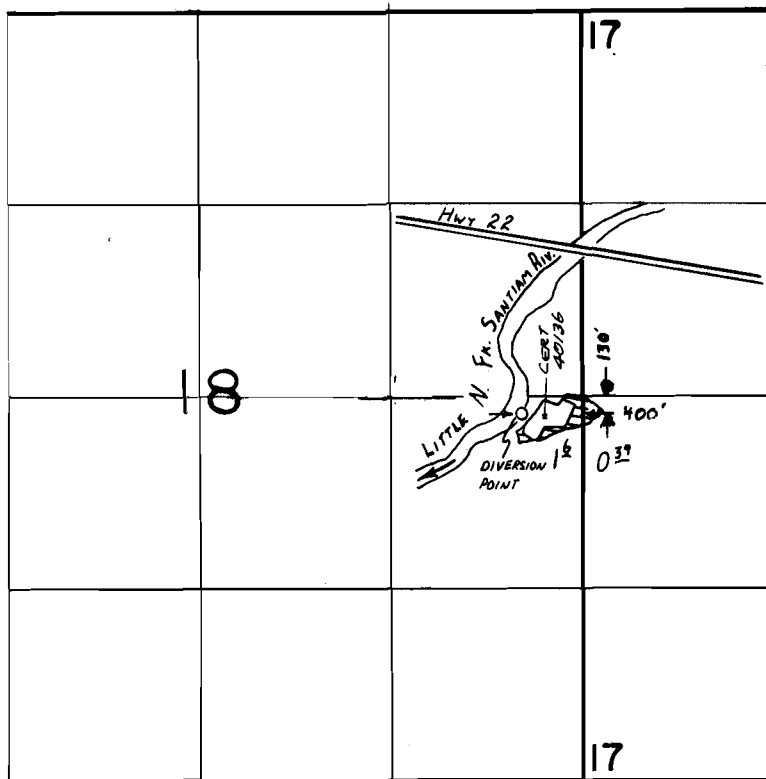

SCALE
1" = 1320'

FINAL PROOF SURVEY
UNDER

Application No. 62916.. Permit No. 46605....
IN NAME OF

.....RODGER FUDGE, JR.....

Surveyed MAY...5... 1986., by T.M. WARREN..