


T.37S. R.5&6W. W.M.

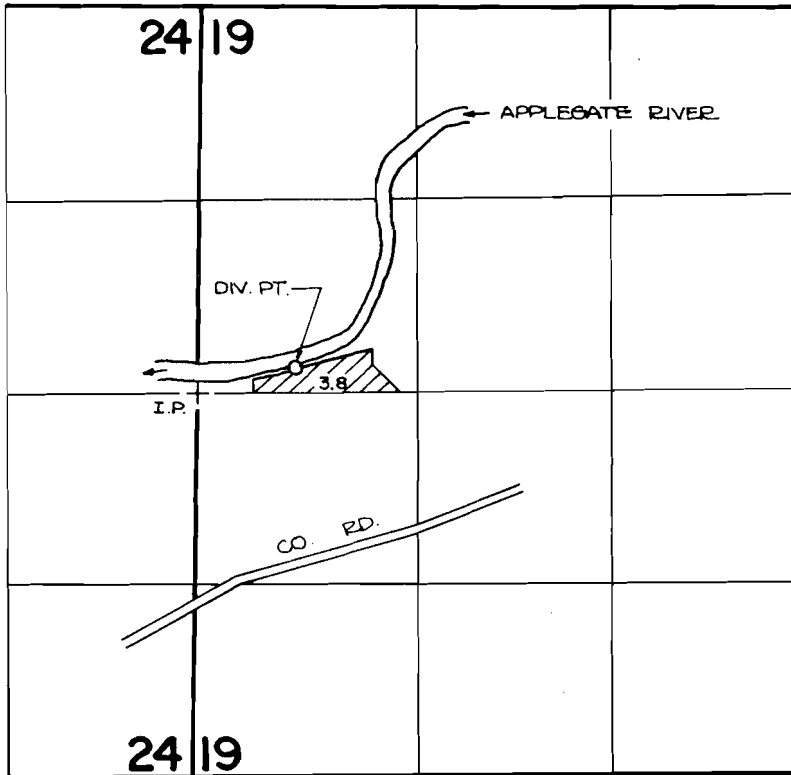

DIVERSION POINT IS LOCATED 2360'S. AND 700'E. FROM THE N.W. CORNER OF SECTION 19.

FINAL PROOF SURVEY
UNDER

Application No. 62327.. Permit No. 46623....
IN NAME OF

MICHAEL A. & KATHLEEN E. MILLETTE

Surveyed OCT.13.. 1983, by ...**B. JAMES**