


T. 37 S., R. 6 W., W.M.

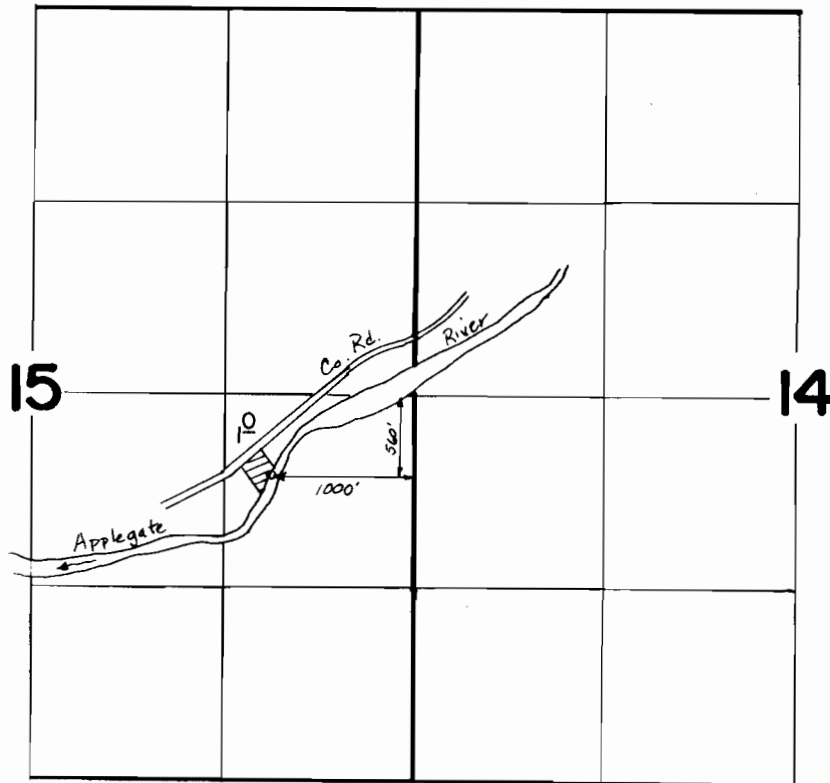

FINAL PROOF SURVEY
UNDER

Application No. 62379, Permit No. 46738.....

IN NAME OF

PETER VAN WAARDENBERG

Surveyed OCT. 19, 1983, by B. S. JAMES.....