


# T.7 & 8 S., R.3 & 4 W., W.M.

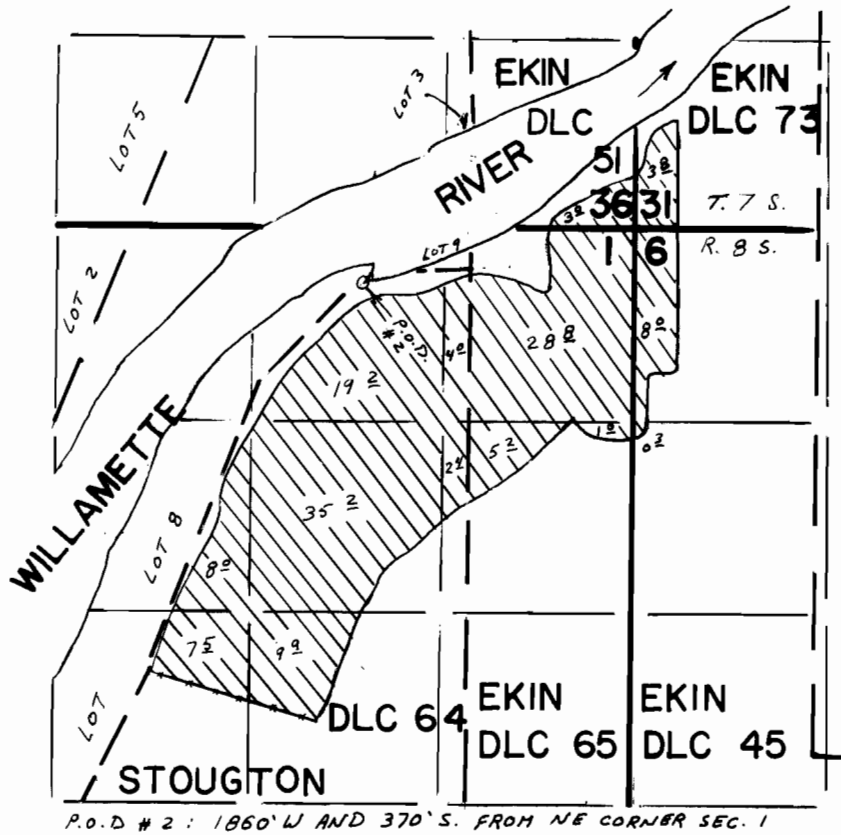

SCALE 1" = 1320'

## FINAL PROOF SURVEY UNDER

Application No. **63454** Permit No. **46921**  
IN NAME OF

**PIONEER FARMS**

Surveyed **JUL 7 1988** by **Z. SALEH**