


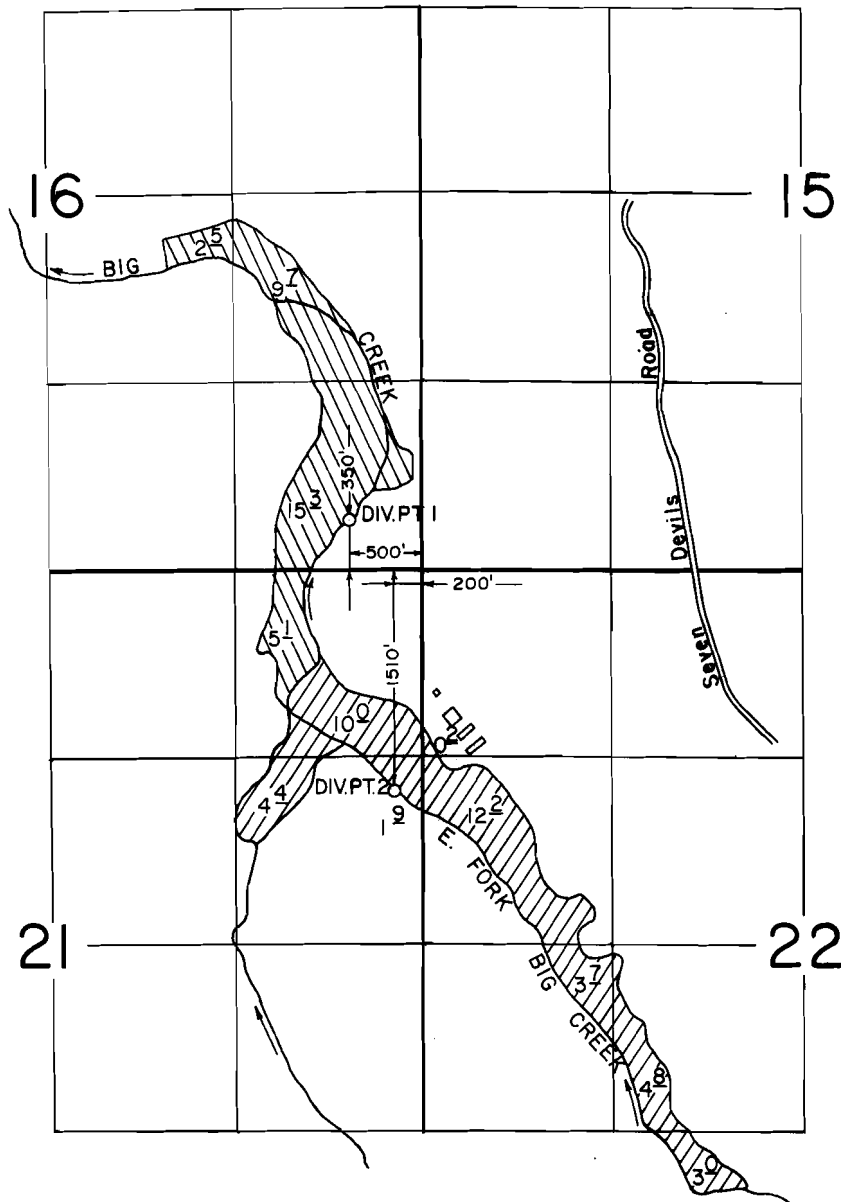

T. 26 S., R. 14 W., W.M



SCALE: 1" = 1320'

 DIV. PT. 1
 DIV. PT. 2

FINAL PROOF SURVEY UNDER

Application No. 63047... Permit No. 46986.....
IN NAME OF

ANNE L. KURZET

Surveyed SEPT. 17, 1988., by J. R. KAUPPILA.