


T. 9 & 10 S., R. 6 & 7 W., W.M.

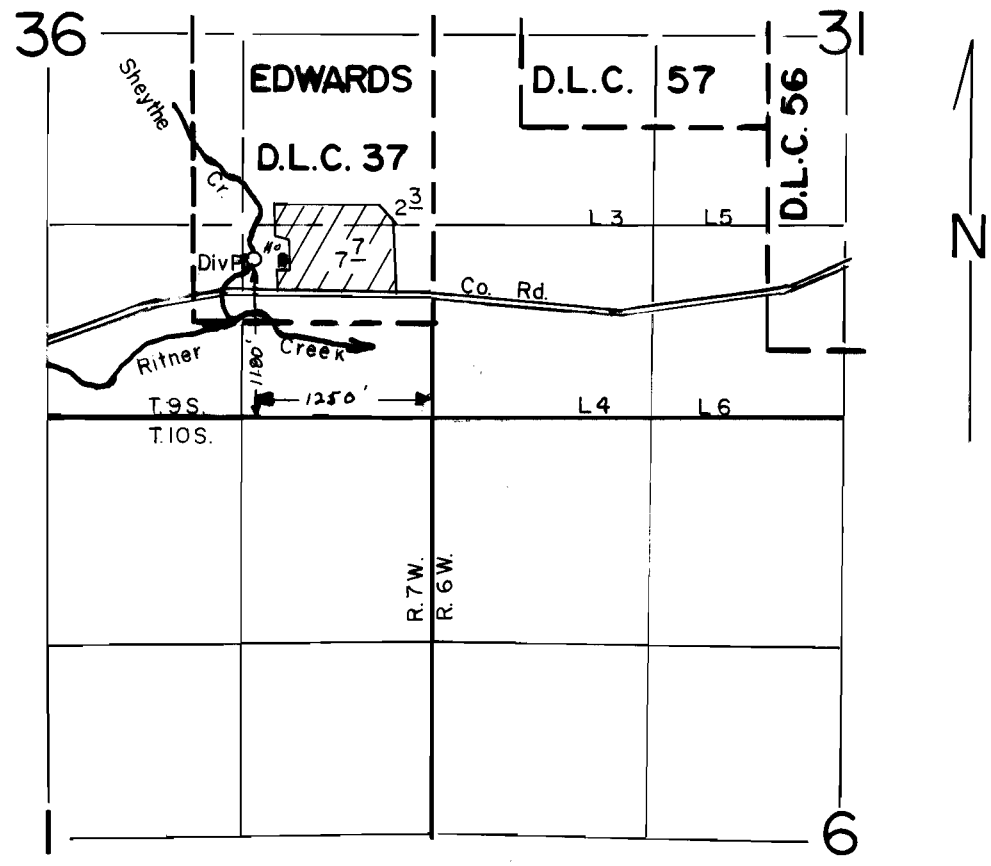

SCALE: 1" = 1320'

**FINAL PROOF SURVEY**  
UNDER

Application No. 63962... Permit No. 47057.....  
IN NAME OF

**AARON L. & VIRGINIA A. BURBANK**

Surveyed MAY. 28... 1987... by B.W. BISHOP.....