


T.2S.,R.2W.,W.M.

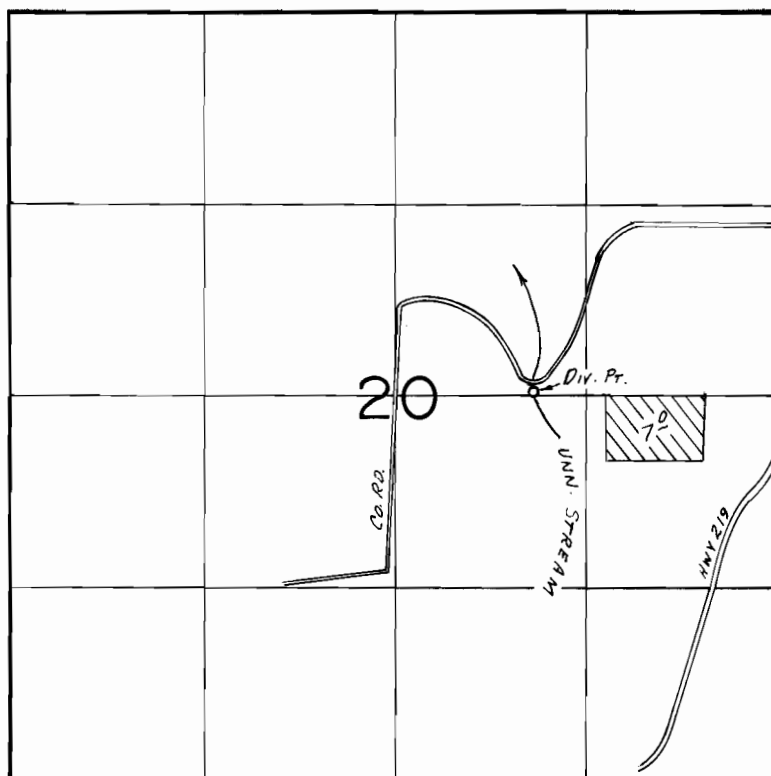

Div. Pt. Loc.: 20' N. & 1690' W. FROM E. 1/4 COR. SEC. 20.

SCALE: 1"=1320'

FINAL PROOF SURVEY UNDER

Application No. 64523.. Permit No. 47186.....
IN NAME OF

.....CAROLE S. LAUGHLIN.....

Surveyed July..18.. 19.84, by B.W. BISHOP.....