


T. 6 S., R. 6 W., W.M.

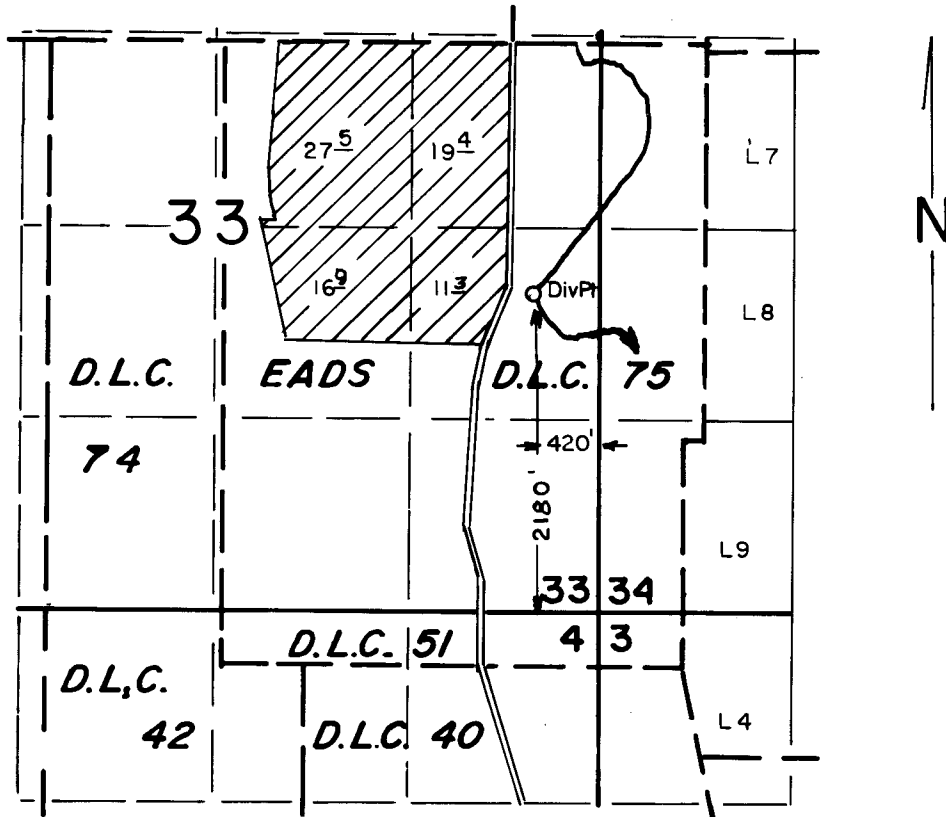

SCALE: 1" = 1320'

FINAL PROOF SURVEY UNDER

Application No. 64.5.26.. Permit No. ..474.22.....
IN NAME OF

.....KEN.....CRUICKSHANK.....

Surveyed ..MAY.21.. 1987.., by ..B.W..BISHOP.....