


T. 38 S., R. 4 W., W. M.

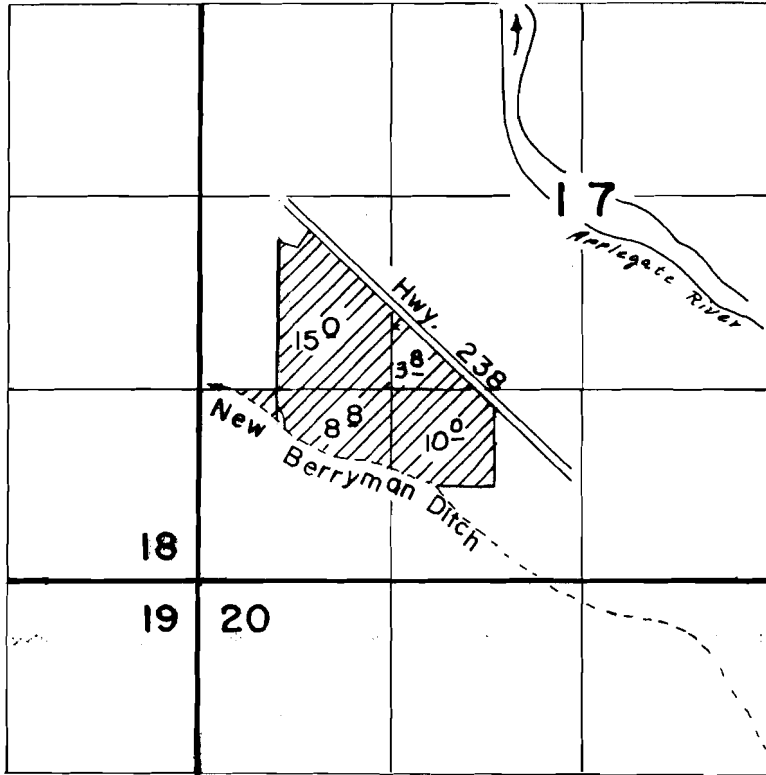

New Berryman Ditch Diversion:

1050' S., 500' W., from N 1/4 cor. Sec. 25,
in NE 1/4 NW 1/4, Sec. 25, T. 38 S., R. 4 W., W. M.

FINAL PROOF SURVEY
UNDER

Application No. 61955 Permit No. 47508
IN NAME OF

JAKE KUITERT

Surveyed AUG. 12. 1987, by L. M. JOACHIMS