


T. 4S., R. 40E., W.M.

SECTION 2 SW1/4 SE1/4

SCALE 1" = 400'

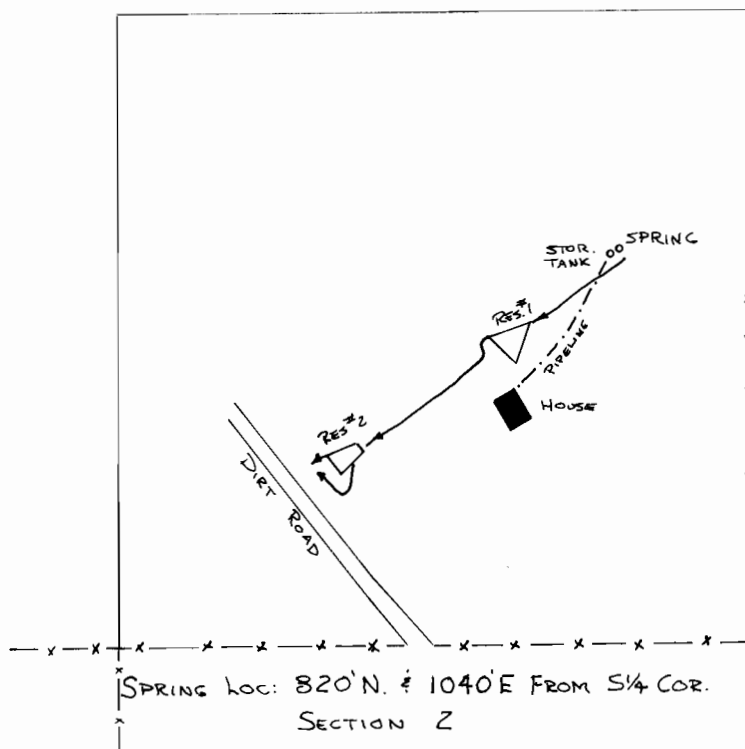

FINAL PROOF SURVEY
UNDER

Application No. **65206** Permit No. **47652**....
IN NAME OF

ALBERT E. JACOBS.....

Surveyed **SEPT. 8, 1988**, by **V. L. Church**.....

PTS

VLC