


# T.9S., R.45E., W.M.

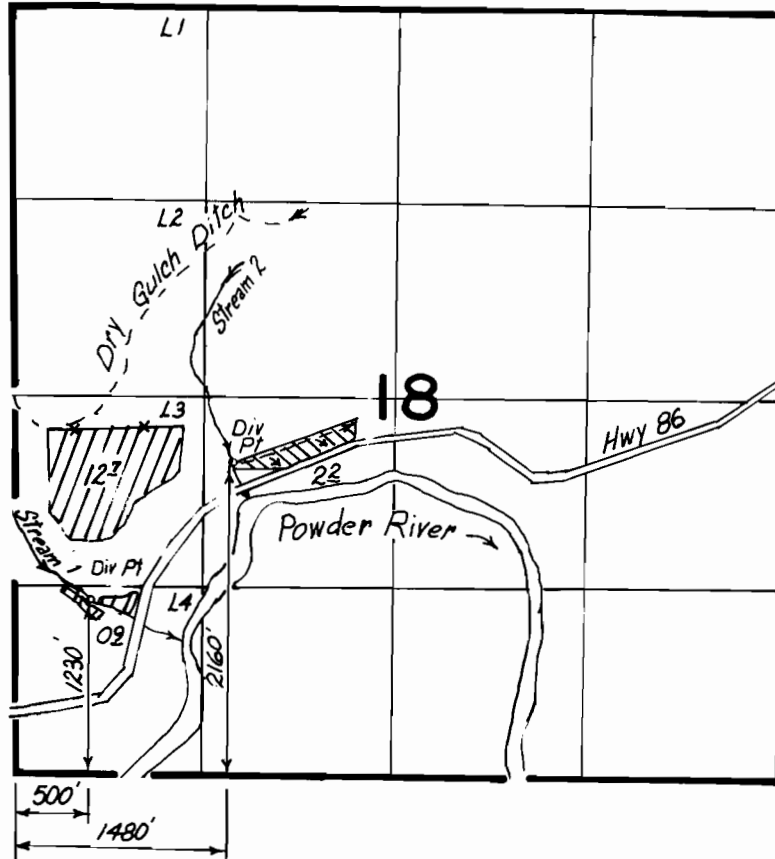

Scale: 1" = 1320'

## FINAL PROOF SURVEY UNDER

Application No. 62934 Permit No. 47674  
IN NAME OF

LEONARD KNIGHT

Surveyed 10-4 1988, by Kenn Kemp



Stream 1 Irrigation



Stream 2 Irrigation