


T. 9S., R. 6W., W.M.

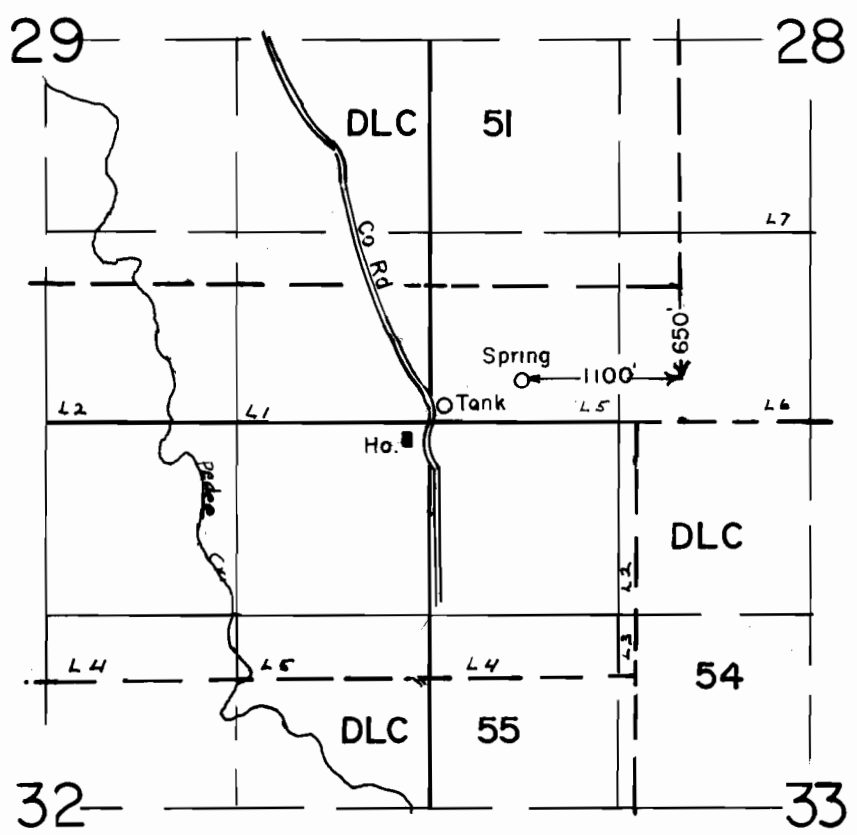

SCALE: 1"=1320'

FINAL PROOF SURVEY
UNDER

Application No. 68055... Permit No. 48448.....
IN NAME OF

.....GARRETT VAN DIEST, INC.....

Surveyed JULY 8..... 1985., by B.W.BISHOP.....